


T.I.S.R.I.W.W.M.

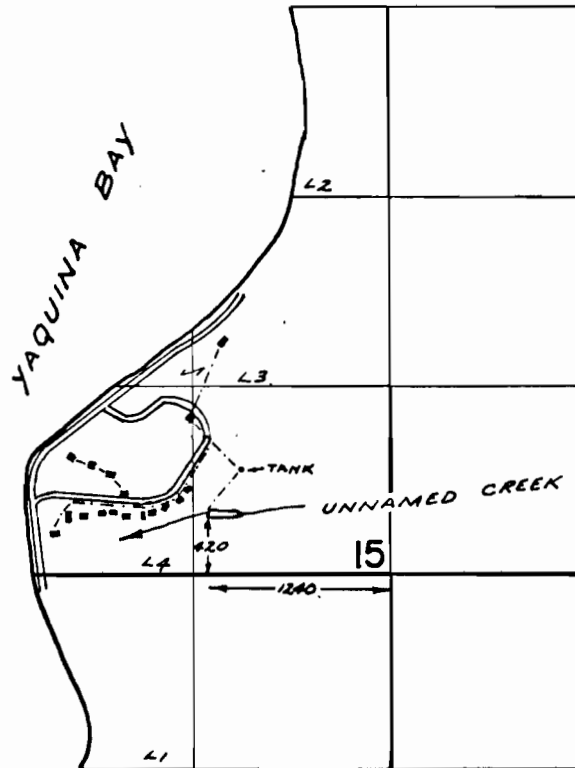

**FINAL PROOF SURVEY**  
UNDER

Application No. *R-43957* *42128* Permit No. *R-4977* *32368*  
IN NAME OF

*BAY HILLS WATER IMPROVEMENT DIST. INC.*

Surveyed *SEPT. 17, 1973*, by *R. MUGKEN*.