


T.I.S.R.I.W.W.M.

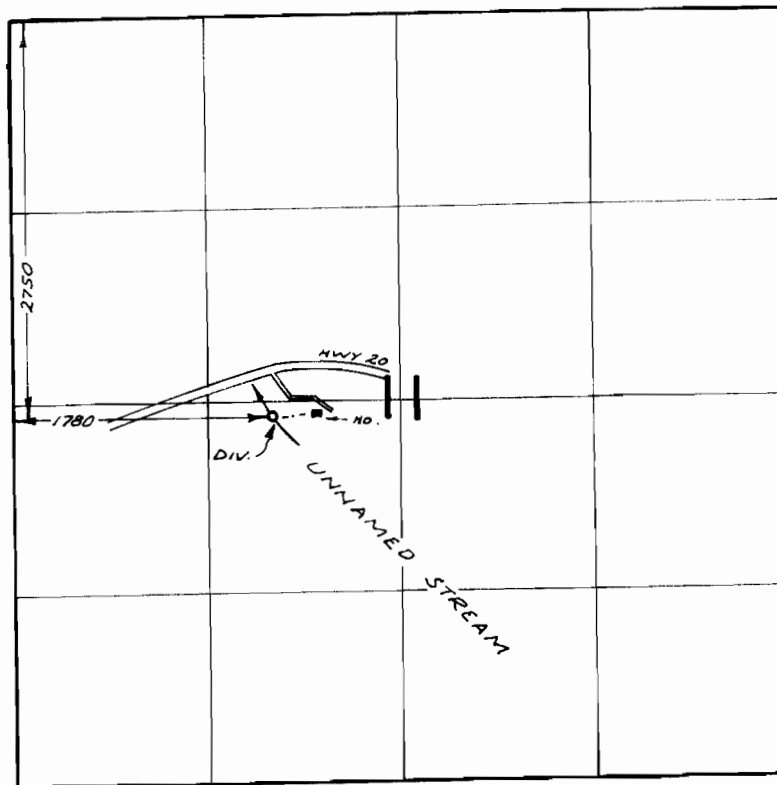

FINAL PROOF SURVEY
UNDER

Application No. 41822 Permit No. 31303
IN NAME OF

ROBERT J. & VIRGINIA L. BRAYTON

Surveyed SEPT. 20, 1973, by R. MUCKEN