


T.II.S.R.IIW.W.M.

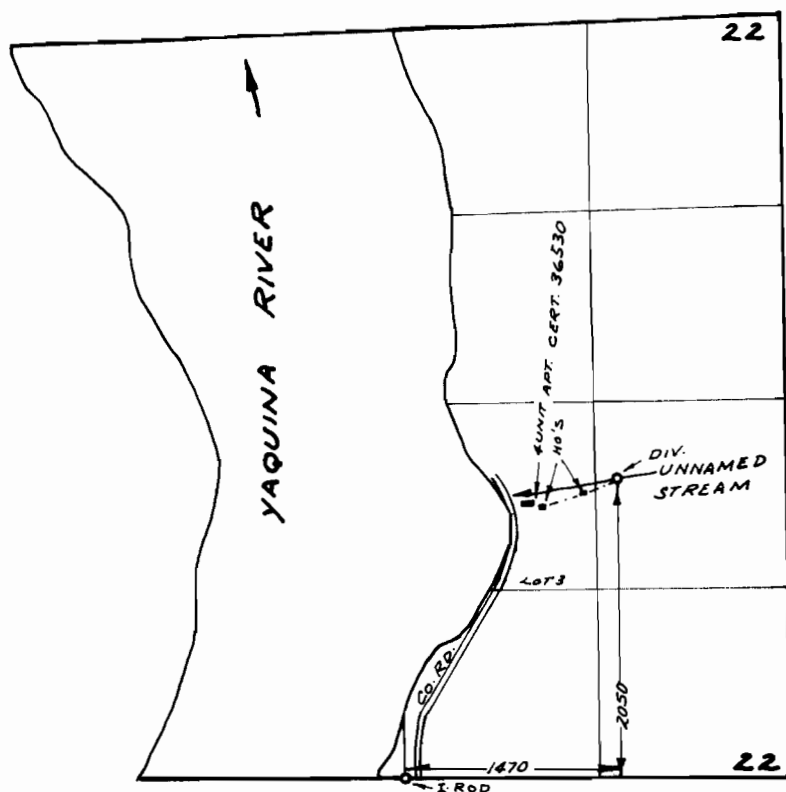

FINAL PROOF SURVEY
UNDER

Application No. 4670.5 Permit No. 3490.2
IN NAME OF

R.C. YARBROUGH

Surveyed SEPT. 17 19.23, by R. MUGKEN