


T.17S.,R.47E.,W.M.

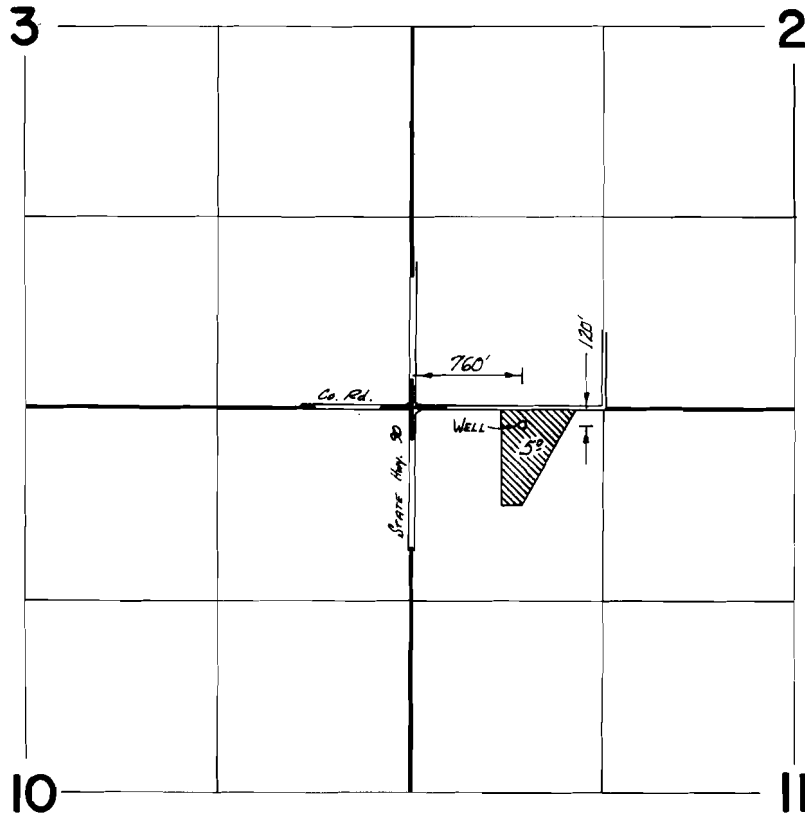

FINAL PROOF SURVEY
UNDER

Application No. G-2923 Permit No. G-2870
IN NAME OF

Estate of Monte Guina

Surveyed May 26 1973, by D. NORBY