


T.1S. R.3&4E. W.M. .

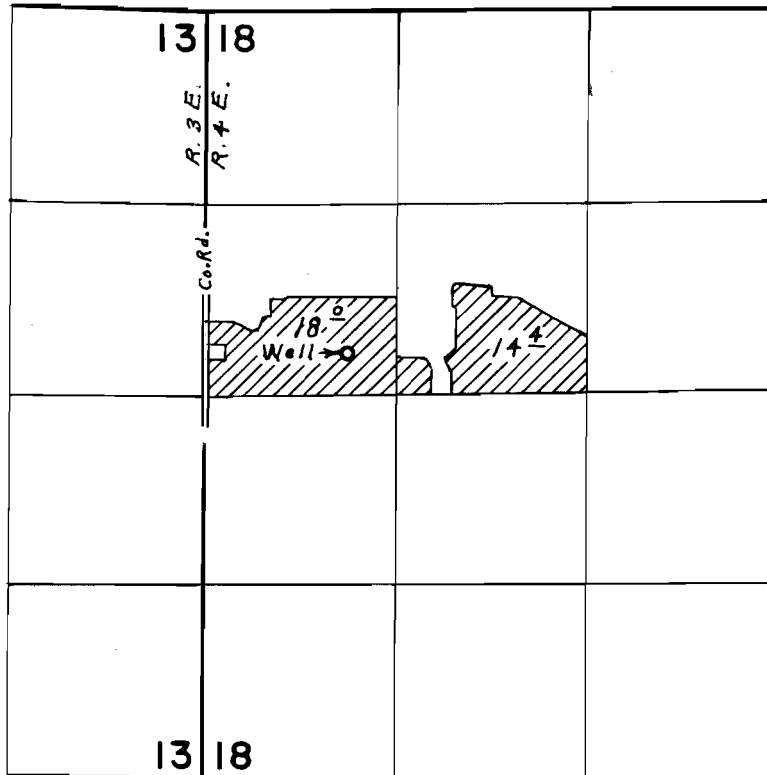

Well located 280' N. & 970' E. from W. $\frac{1}{4}$ Cor. Sec. 18

FINAL PROOF SURVEY
UNDER

Application No. G-4671 Permit No. G-4399
IN NAME OF

CARL EKSTROM

Surveyed Sept. 12, 1973, by L. E. Gould