


T.1S. R.4E. W.M.

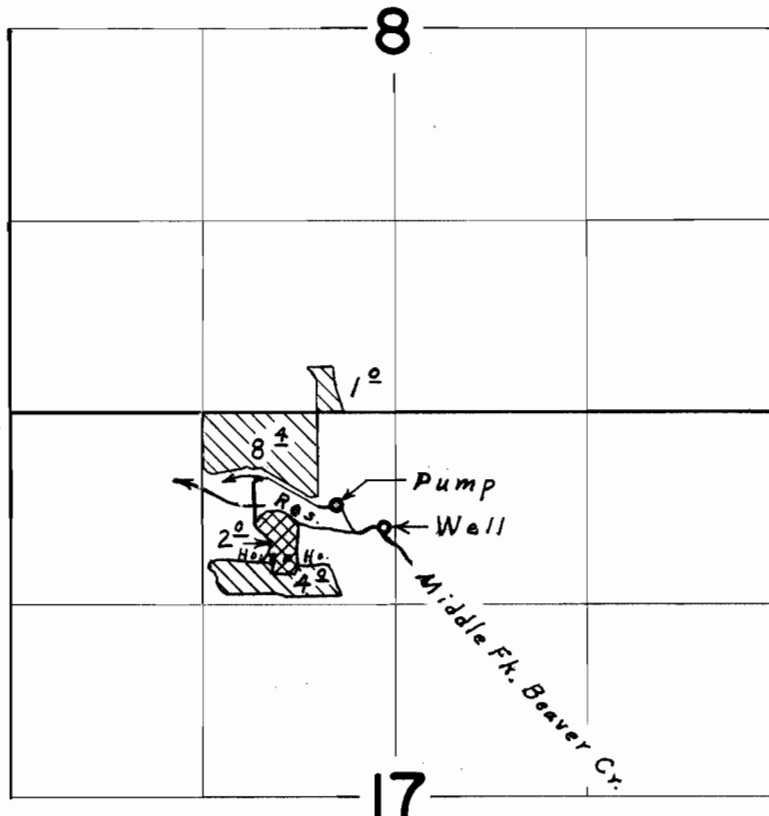

Div. Pts. located: Res., 640' S. & 970' W.; Well, 780' S
& 80' W., BOTH FROM N¹/₄ COR. SEC. 17

FINAL PROOF SURVEY
UNDER

G-3649 G - 3428
R-39112 R - 3872
Application No. 39113... Permit No. 29176.
IN NAME OF

LATHIE E. BELCHER

Surveyed Sept. 11, 1973, by L. E. Gould