


T.1N. R.4&5E. W.M.

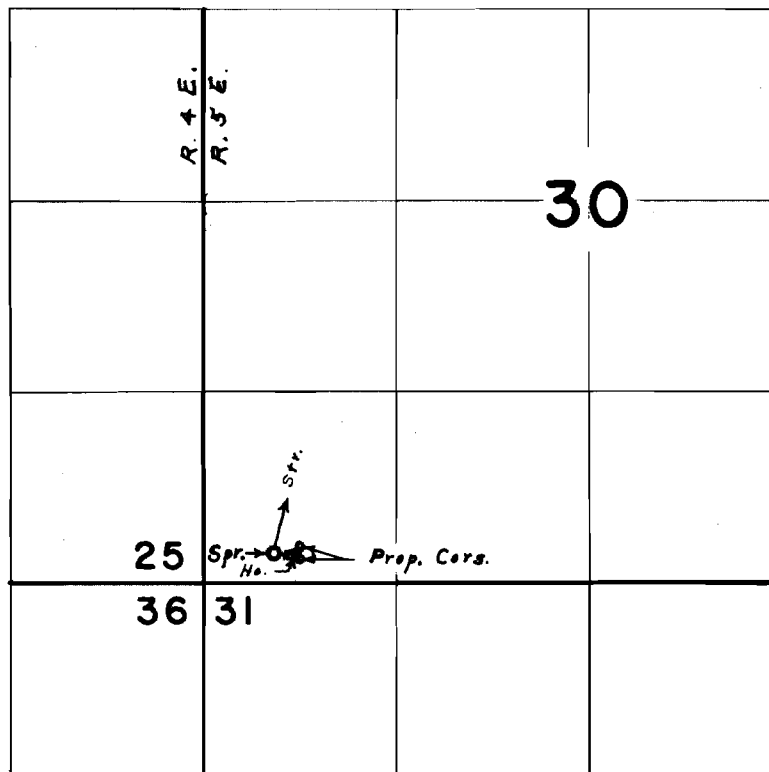

Spr. loc. 200' N. & 480' E. from S.W. Cor. Sec. 30

FINAL PROOF SURVEY
UNDER

Application No. 41941 Permit No. 31456
IN NAME OF

WESLEY P. CUNNINGHAM

Surveyed Sept. 13, 1973, by L. E. Gould