


T.1N. R.3&4E. W.M.

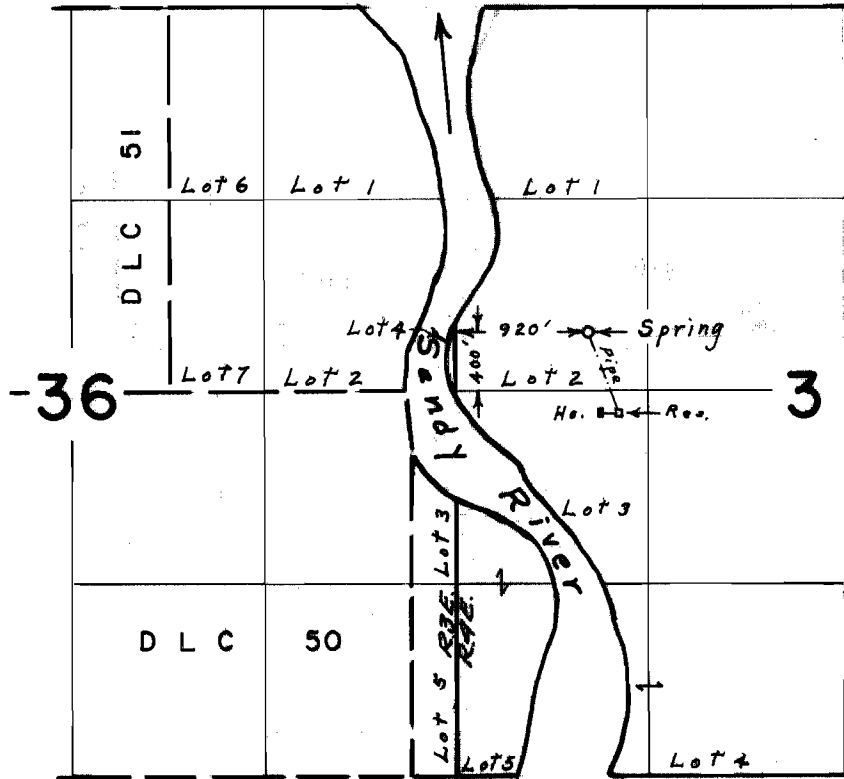

**FINAL PROOF SURVEY**  
UNDER

Application No. 43638 Permit No. 32624  
IN NAME OF

MERLE D. & ETHEL D. SELLIN

Surveyed May 11, 1973, by L. E. Gould