


T.1N.&1S. R.3&4E. W.M.

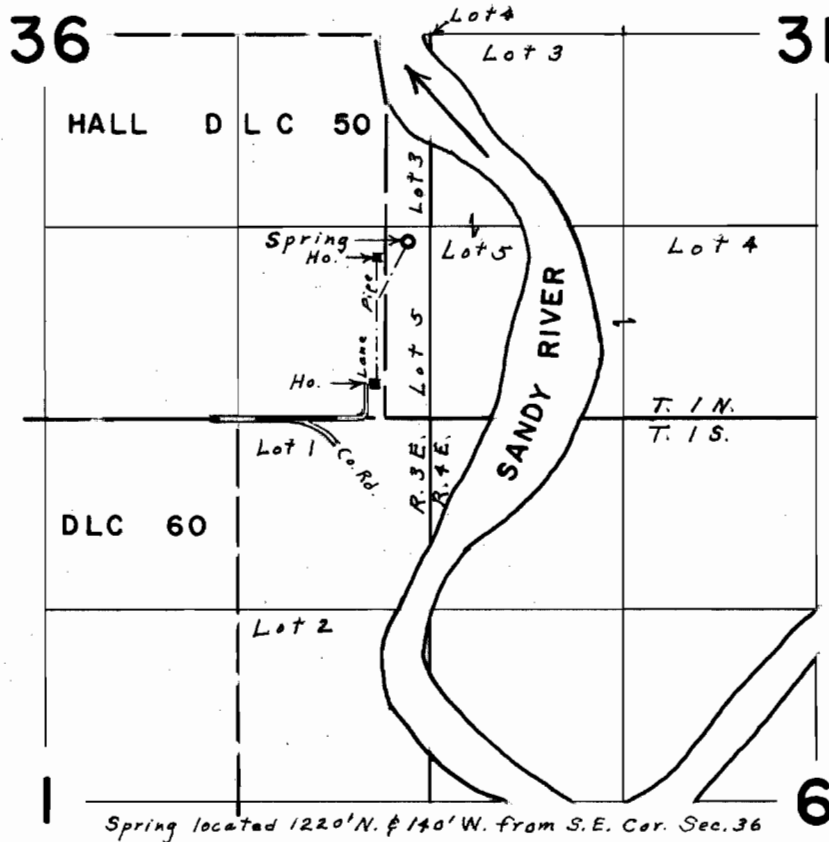

**FINAL PROOF SURVEY**  
UNDER

Application No. 4.74.1.5. Permit No. 3.5.5.3.1.  
IN NAME OF

**ROBERT D. & FRANCES JEAN ALLEGRE**

Surveyed May 9, 1973, by L. E. Gould.