


T. 3N. R. 10W. W. M.

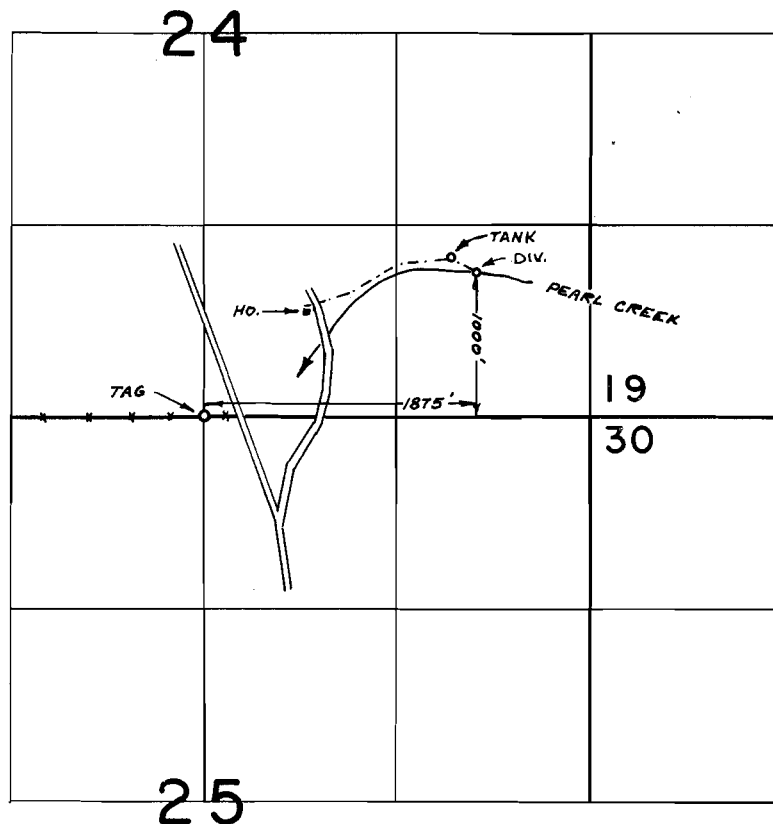

FINAL PROOF SURVEY
UNDER

Application No. 48351 Permit No. 36304
IN NAME OF

LESTER C. WALKER

Surveyed MAY 2 19 73, by R. MUCKEN