


T. 3N. R. 10W. W.M.

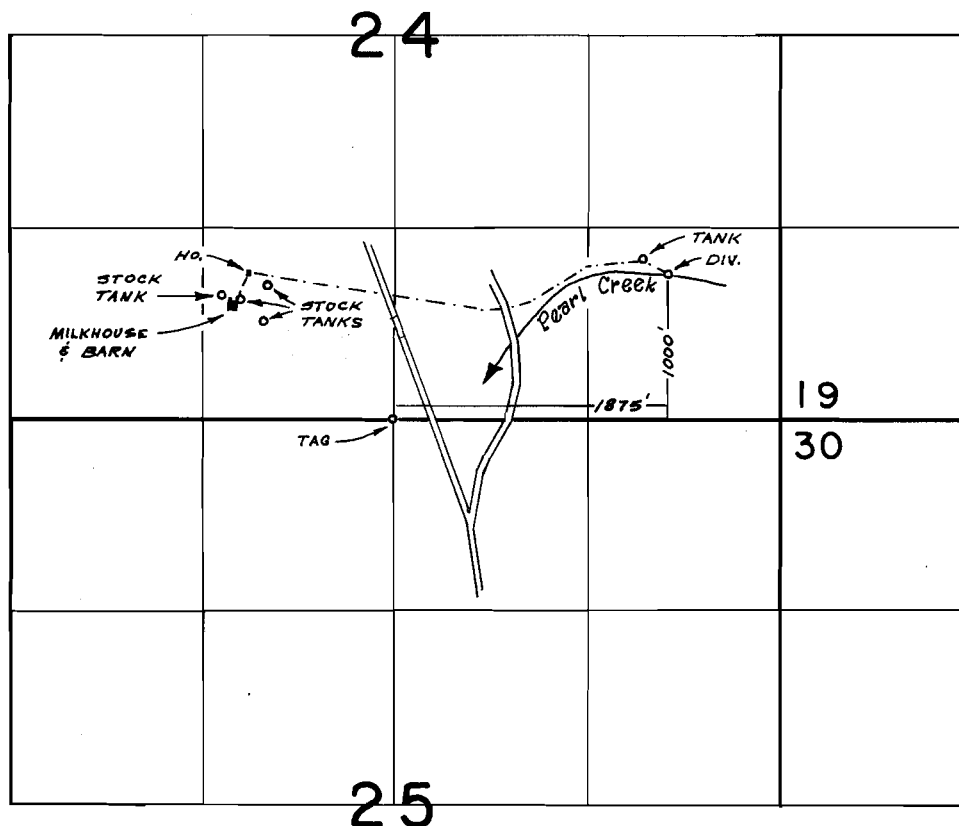

FINAL PROOF SURVEY
UNDER

Application No. 48352 Permit No. 36305
IN NAME OF

VERNA HUNT

Surveyed MAY 2 1973, by R. MUCKEN