


# T.1S. R.45E. W.M.

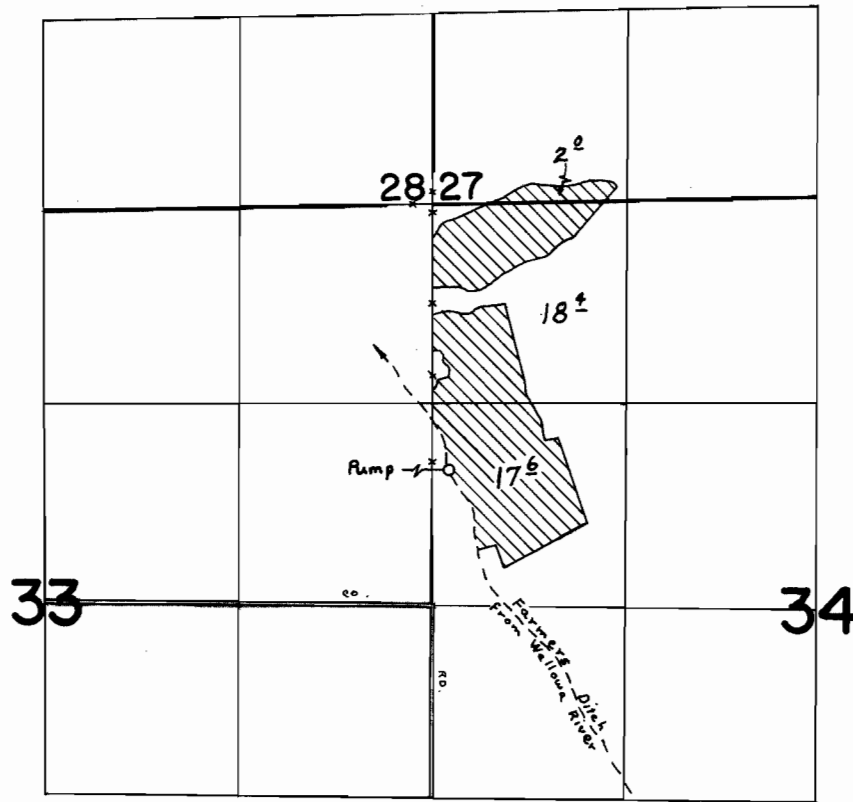

Div. Pt. Loc:  $S. 77^{\circ} 20' E. 624'$  From NW cor. Sec. 5 T. 3S. R. 45E. W.M.  
Pump Loc:  $1820' S. 6^{\circ} 12' E.$  From NW cor. Sec. 34

## FINAL PROOF SURVEY UNDER

Application No. 42928 Permit No. 32074

IN NAME OF

GIFFORD BOTTS

Surveyed AUG. 2, 1973, by R. MUCKEN