



T.1N.,R.43E.,W.M.

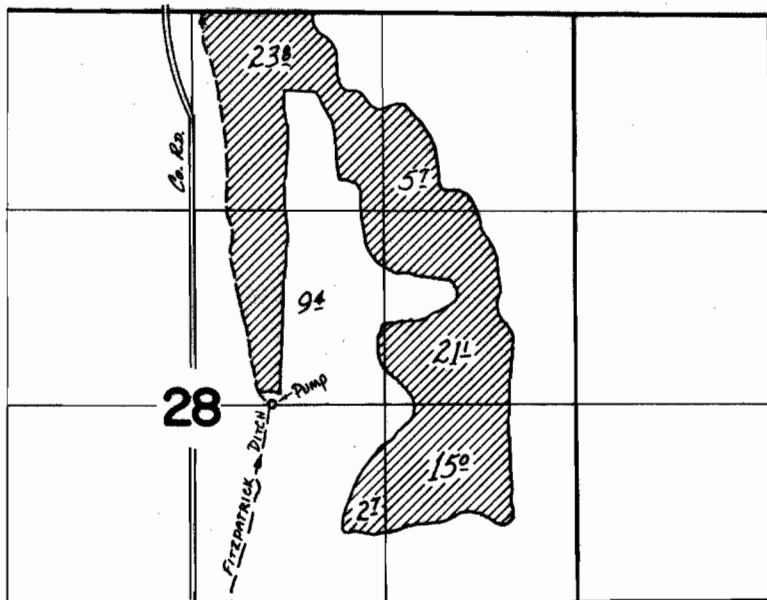

T.1S., R.43E., W.M.

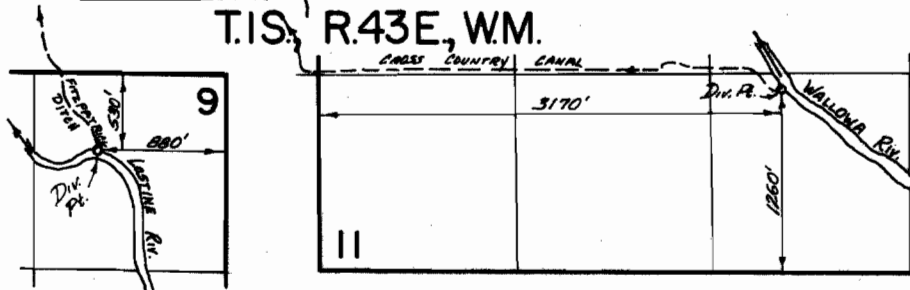

FINAL PROOF SURVEY
UNDER

Application No. 44818 Permit No. 33521
IN NAME OF

DONALD G. IMSLAND

Surveyed Aug. 10, 1973, by D. Nobby