


# T.2S.R.IW. W.M.

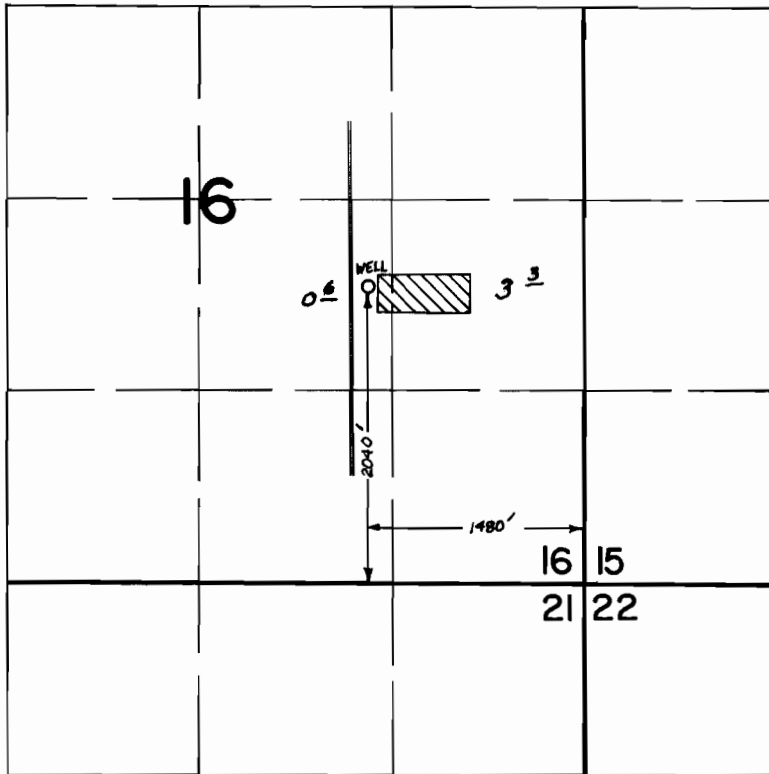

## FINAL PROOF SURVEY UNDER

Application No. G-3240 Permit No. G-3116  
IN NAME OF

*ALAN T. & SUSAN I. HAQUIRE*

Surveyed OCT 4 19 72 by L. GOULD