


T. 1 S., R. 3 W., W.M.

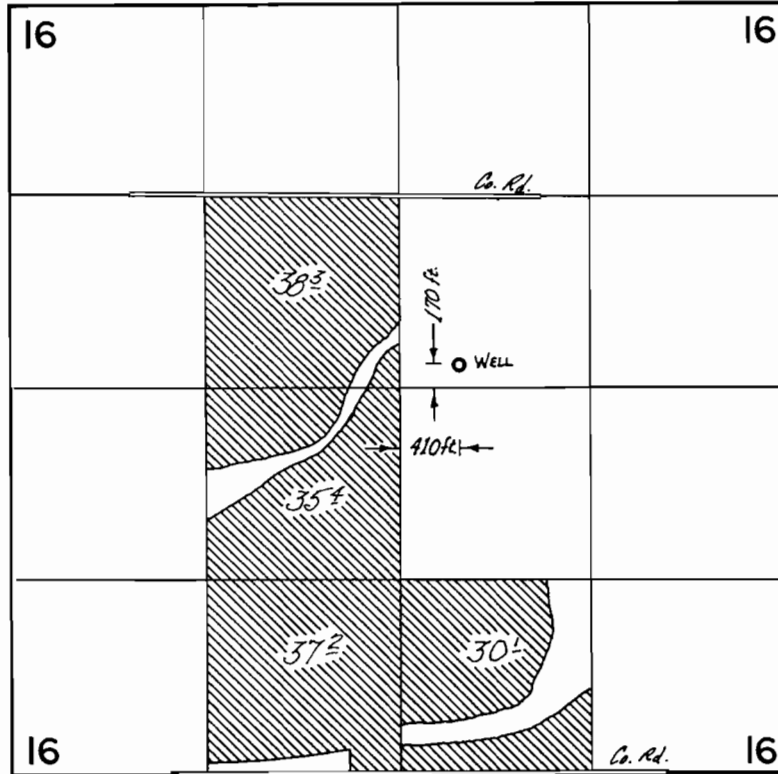

FINAL PROOF SURVEY
UNDER

Application No. G-3690 Permit No. G-3494
IN NAME OF

.....DONALD C. JESSE.....

Surveyed 15 JUNE 1972, by D. NORBY.....