


T. 3S. R. 39E. W.M.

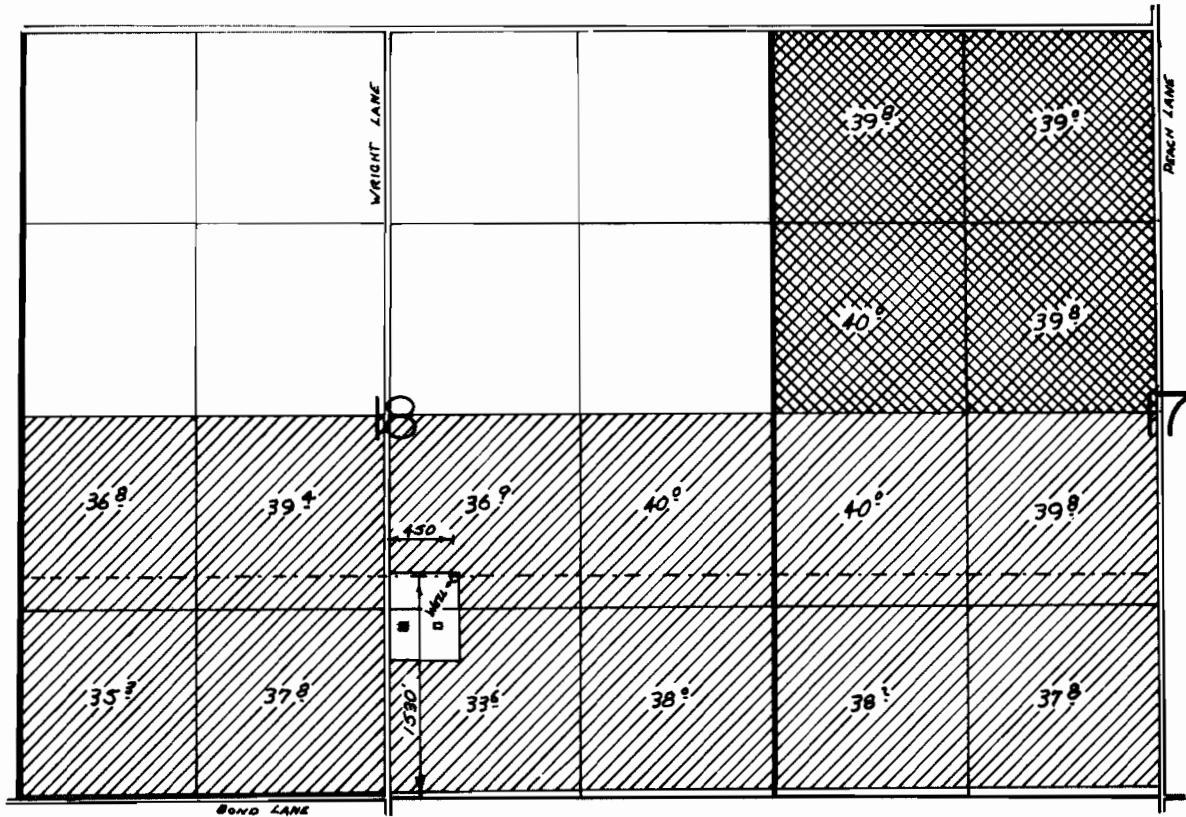

FINAL PROOF SURVEY
UNDER

Application No. G-3557 Permit No. G-3362
IN NAME OF

R. A. & MARION BROBOITTI

Surveyed July 14 1972, by D. NORBY



PRIMARY



SUPPLEMENTAL