


T.1S. R.38E. W.M.

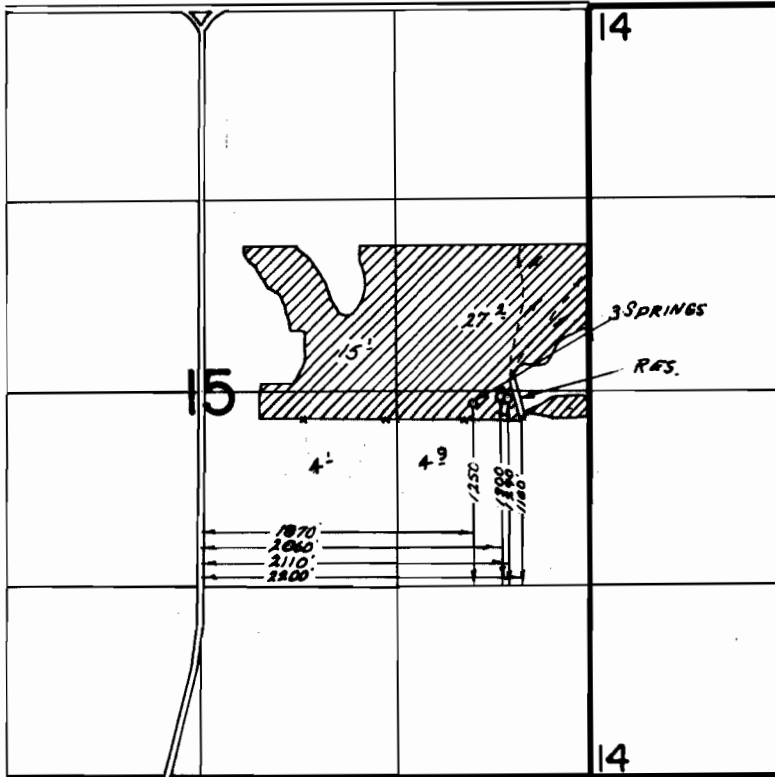

FINAL PROOF SURVEY

UNDER

Application No. R-48537 48538 Permit No. R-5033 52748
IN NAME OF

BERNICE YORK

Surveyed JULY 10, 1973, by R. B. MUCKEN