


T.3S. R.39E. W.M.

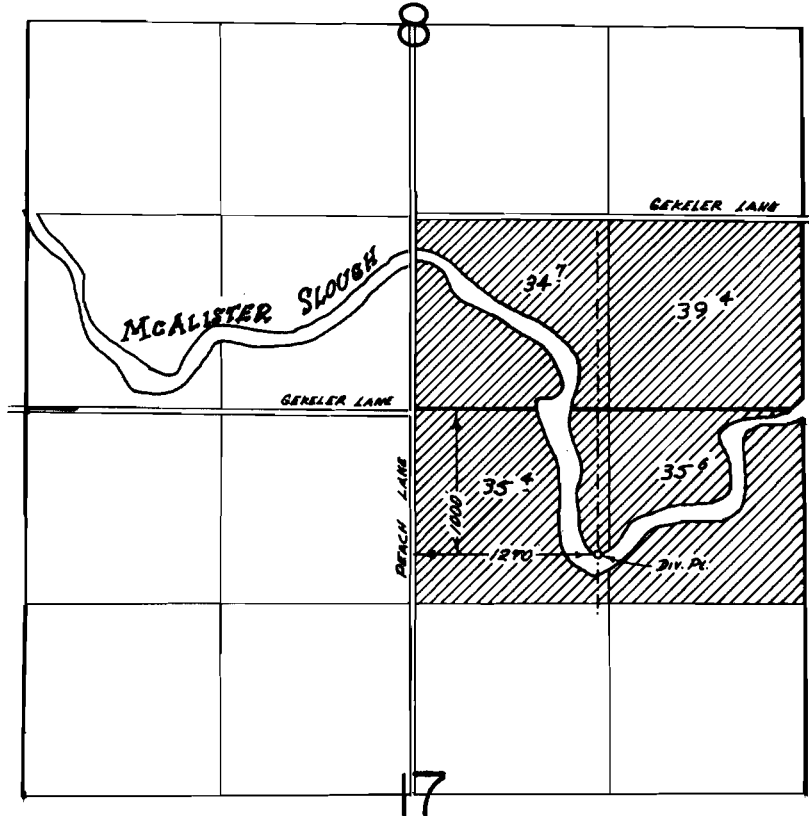

**FINAL PROOF SURVEY**  
UNDER

Application No. 40787 Permit No. 30255  
IN NAME OF

R. A & MARION BROGOITTI

Surveyed July 14 1973, by D. NORBY