


G-3038

41384

T. 4N. R. 34E. WM.

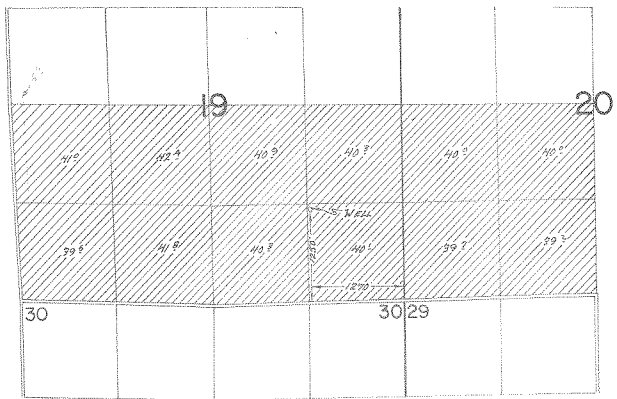

FINAL PROOF SURVEY UNDER

Application No. G-3222 Permit No. G-3029
IN NAME OF

WILLIAM R. JOHNS, MIRIAM W. JOHNS, MAURICE R. & DONNA JOHNS,
JAMES R. & HELEN SMITH & LAWRENCE BEAMER

Surveyed April 17, 1973 by R. B. Murken