


G-3384

41385

T.3N.R.34E.W.M.

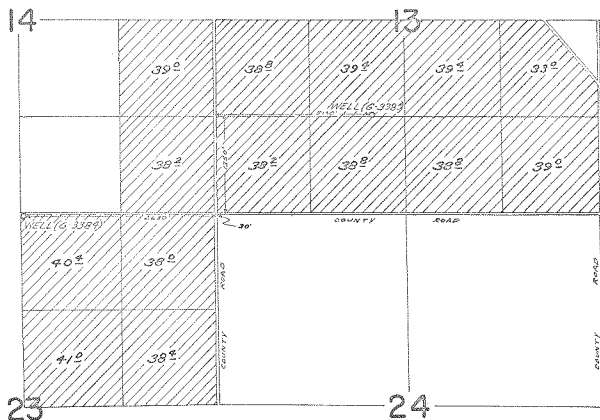

FINAL PROOF SURVEY
UNDER

Application No. G-3597 Permit No. G-3384
G-3592 G-3385
IN NAME OF

BARNETT-RUGG, INC.

Surveyed Apr. 20 1973, by R.G. MUCKEN