


G-3384

41385

## T.3N.R.34E.W.M.

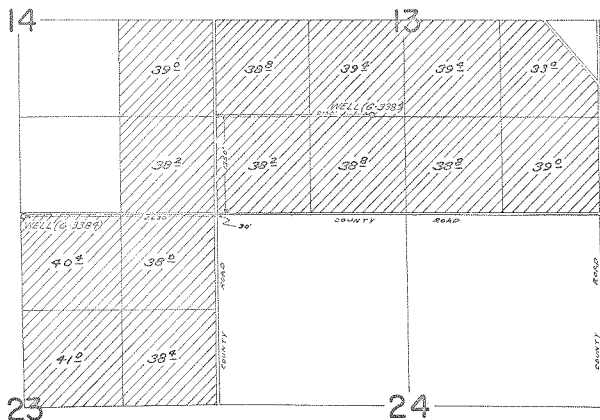

FINAL PROOF SURVEY  
UNDER

Application No. G-3597 Permit No. G-3384  
G-3598 G-3385  
IN NAME OF

BARNETT-RUGG, Inc.

Surveyed Apr. 20 1973, by R.G. MUCKEN