


T.6N. R.35E. W.M.

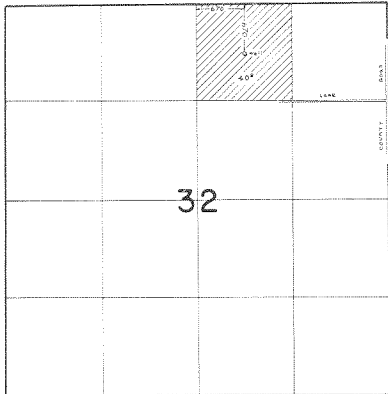

FINAL PROOF SURVEY  
UNDER

Application No. G-4230 Permit No. G-3994  
IN NAME OF

GEORGE H. STRIEGEL

Surveyed APRIL 13, 1973 by R. MUCKEN