


G-4698
4138⁹¹

T.6N. R.35E. W.M.

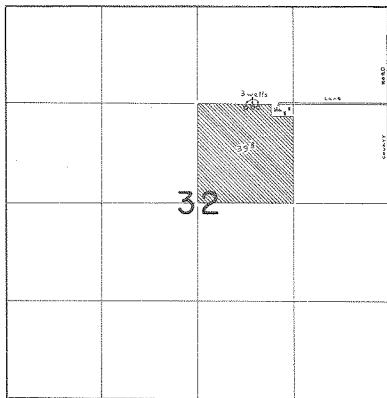

Wells Loc: #1- 1310'N. $\angle$ 890'E. #2- 1310'N. $\angle$ 770'E. #3- 1308'N. $\angle$ 670'E,
all from cen. Sec. 32

FINAL PROOF SURVEY
UNDER

Application No. G-4978 Permit No. G-4698
IN NAME OF

CLIFF PRICE

Surveyed APRIL 13, 1973, by R. MUCKEN