


T. 4N.R. 34 & 35 E.W.M.

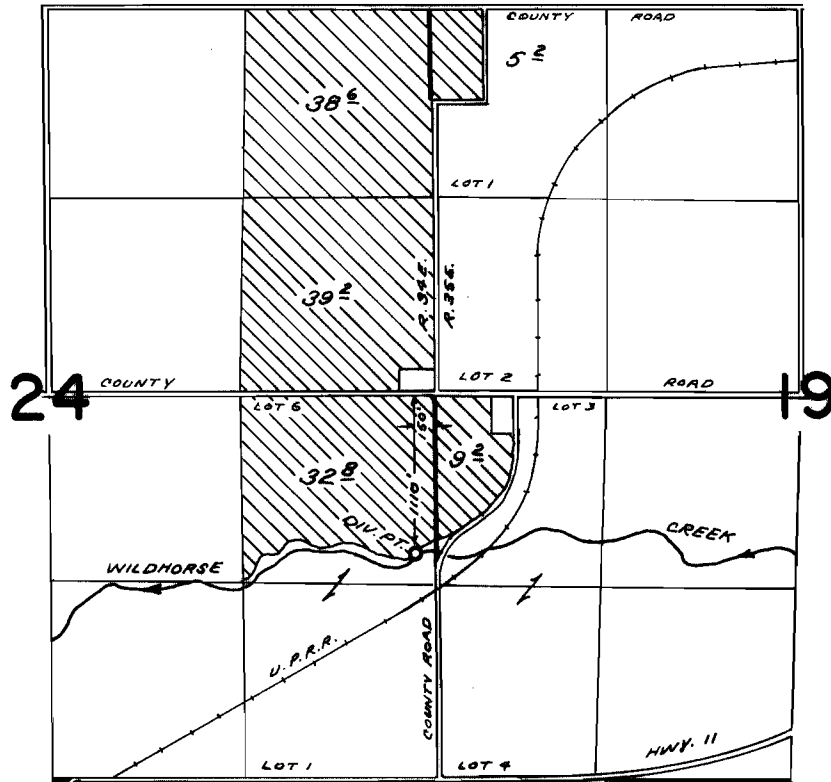

**FINAL PROOF SURVEY**  
UNDER

Application No. 39732 Permit No. 29557  
IN NAME OF

F. N. JOHNS

Surveyed Apr. 17 1973, by R. G. MUCKEN