T. 4 N. R. 34 E. W.M.

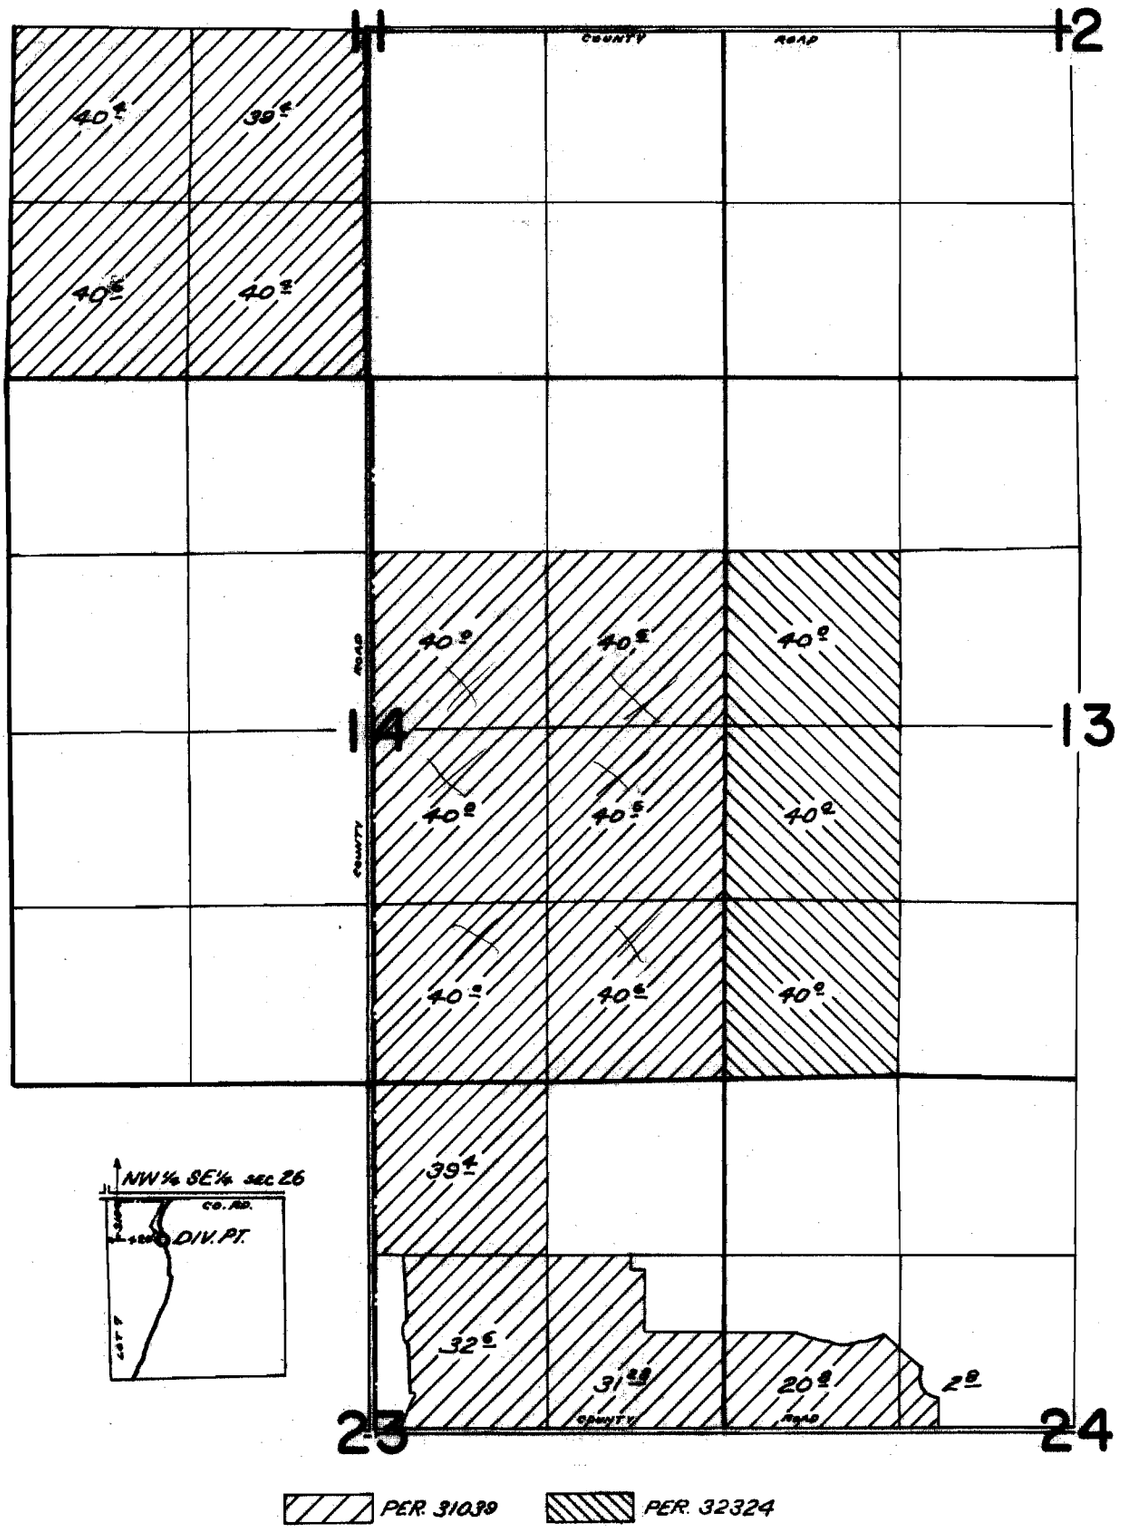

FINAL PROOF SURVEY
UNDER

Application No. 41816, 43236, Permit No. 31039, 32324
IN NAME OF

JOHNS, SMITH, & BEAMER

Surveyed April 17, 1973, by R. G. Mucken