


T.2S. R.5E. W.M.

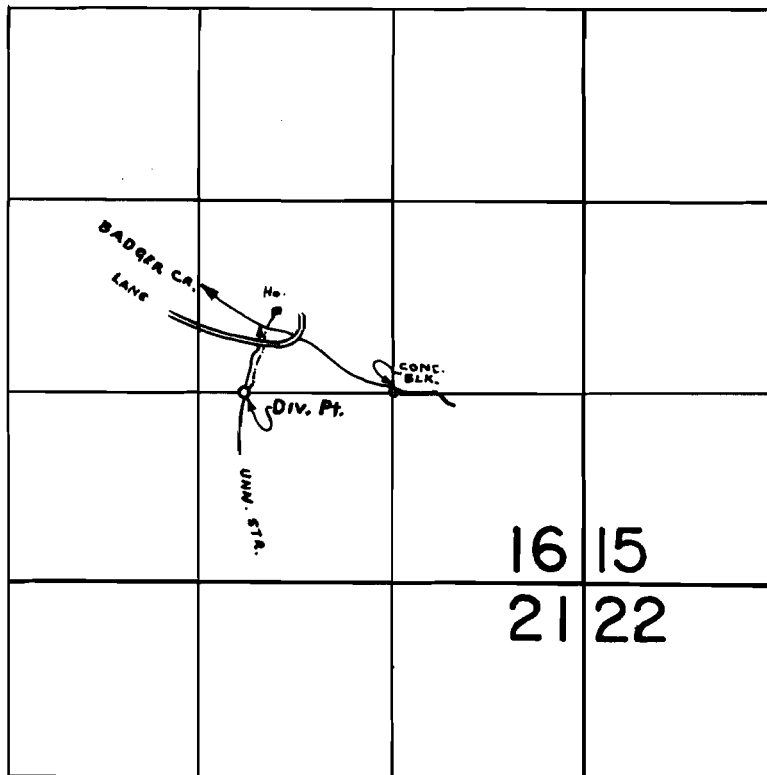

Div. Pt. Loc: 1020' W. from SE cor. NW $\frac{1}{4}$ SE $\frac{1}{4}$ Sec 16

FINAL PROOF SURVEY
UNDER

Application No. 40699 Permit No. 30317
IN NAME OF

ELMER M. SCHWEITZER

Surveyed Sept. 12, 1973, by R. MUCKEN