


T.3S. R.7E. W.M.

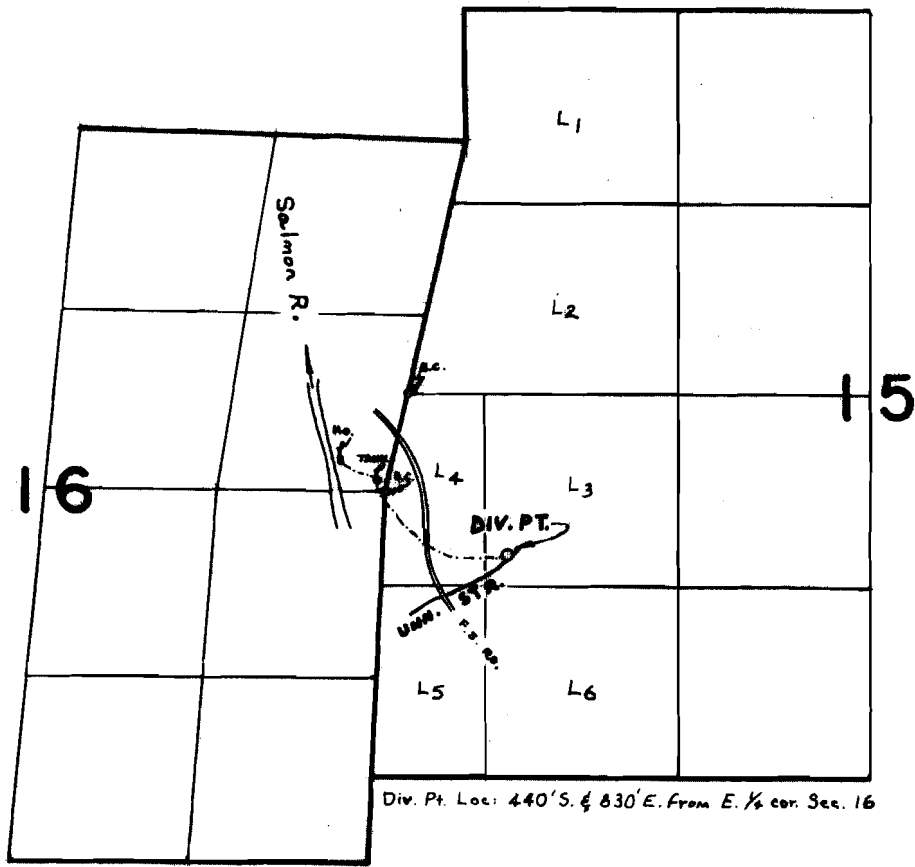

Div. Pt. Loc: 440'S. & 830'E. from E. 1/4 cor. Sec. 16

**FINAL PROOF SURVEY
UNDER**

Application No. 44110 Permit No. 32949
IN NAME OF

MARTIN C. AKIN

Surveyed SEPT. 11, 1973, by R. MUCKEN