


T.3S. R.7E. W.M.

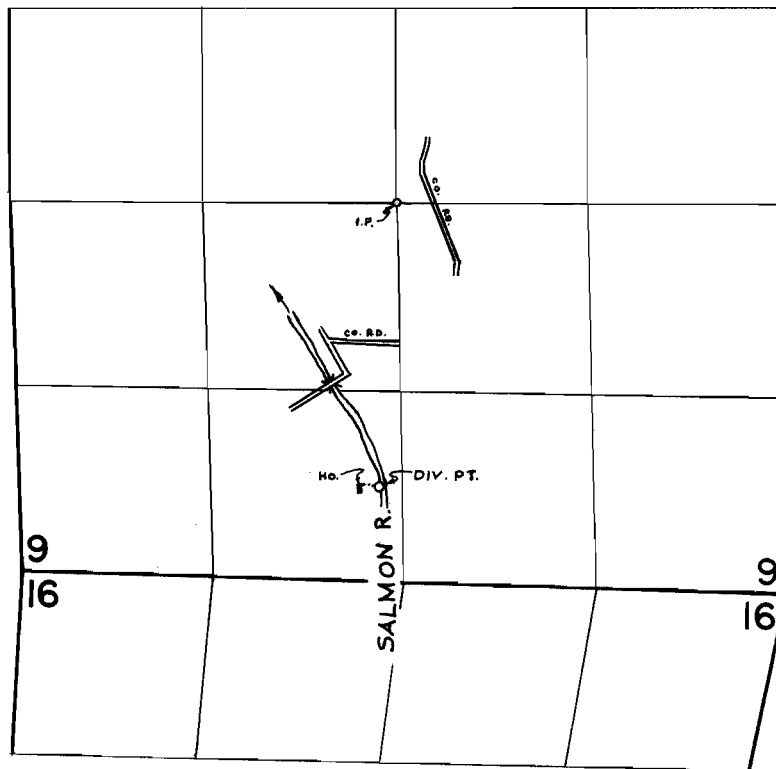

DIV. PT. LOC: 1950' S. & 100' W. FROM CEN. SEC. 9

**FINAL PROOF SURVEY**  
UNDER

Application No. 44611 Permit No. 33426  
IN NAME OF

DONALD EDWARD HANSON

Surveyed SEPT. 10, 1973, by R. MUCKEN