


T.3S. R.7E. W.M.

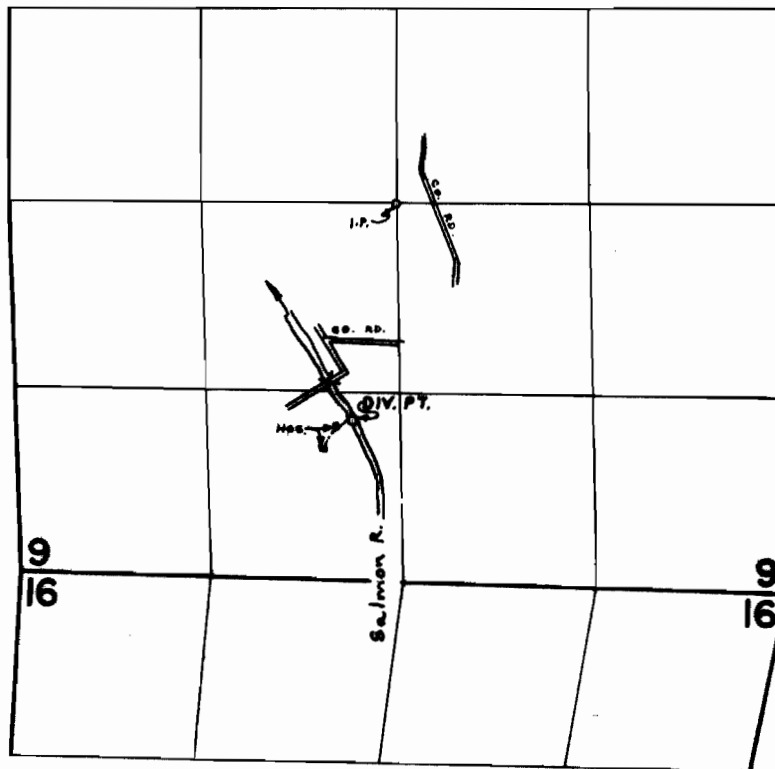

DIV. PT. LOC: 1490' S. & 300' W. FROM CEN. SEC. 9

FINAL PROOF SURVEY
UNDER

Application No. 47246 Permit No. 35389

IN NAME OF

GEORGE A. & ELINE P. HASKELL

Surveyed SEPT. 10, 1973 by R. MUCKEN