


T.3S. R.7E. W.M.

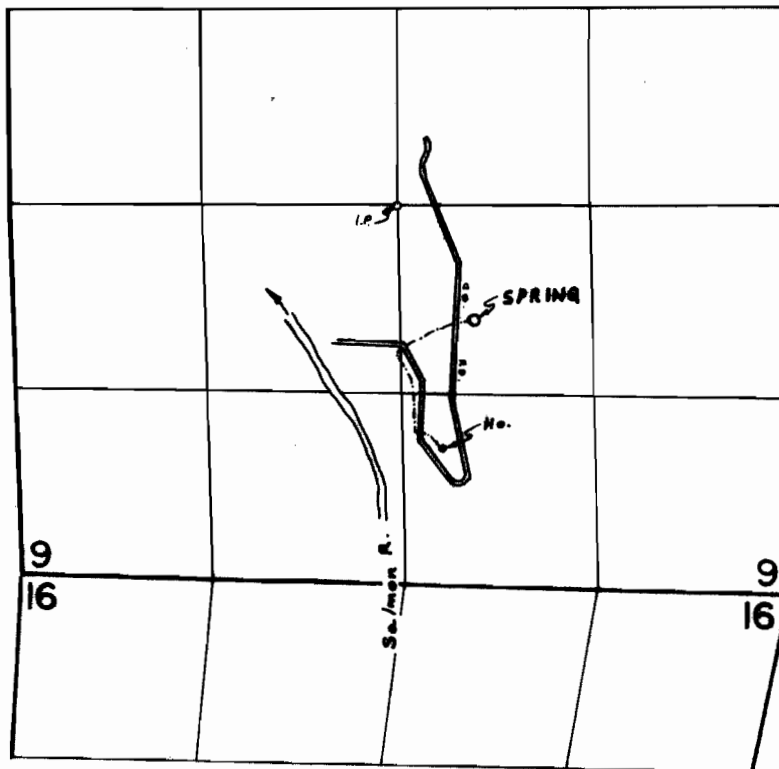

SPRING LOC: 800'S. & 540'E. FROM CEN. SEC. 9

**FINAL PROOF SURVEY  
UNDER**

Application No. 48630 Permit No. 35923  
IN NAME OF

ELMER F. STEUBS

Surveyed SEPT. 10, 1973, by R. MUCKEN