


T. 1 & 2 S. R. 2 & 3 E. W. M.

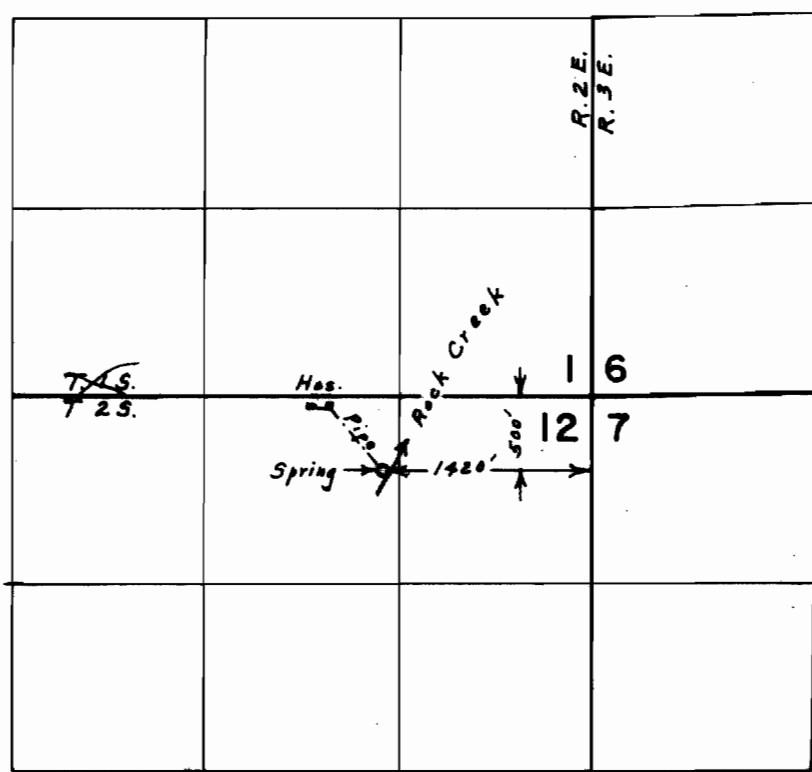

FINAL PROOF SURVEY
UNDER

Application No. 48685 Permit No. 36503
IN NAME OF

WAYNE E. & LORENE S. WESTON

Surveyed Sept. 14, 1973, by L. E. Gould