


T.3.S.R.4E.W.M.

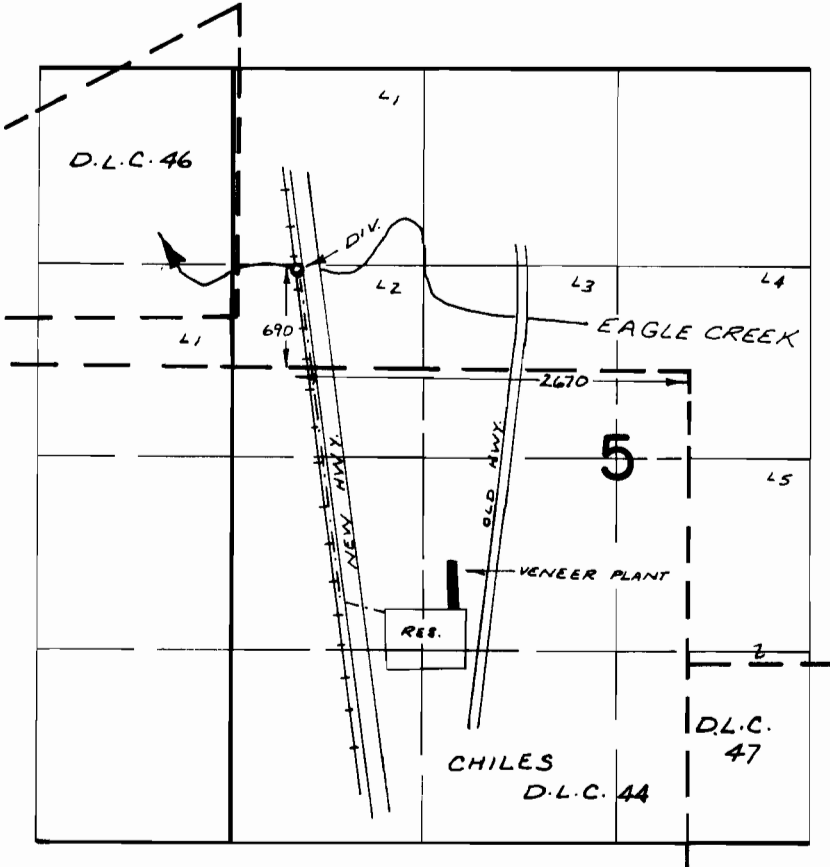

FINAL PROOF SURVEY UNDER

Application No. R-41515 41380 Permit No. R-4673 30973
IN NAME OF

MILWAUKIE PLYWOOD CORPORATION

Surveyed OCT. 3, 1973, by R. MUCKEN.