


T.3S. R.4E. W.M.

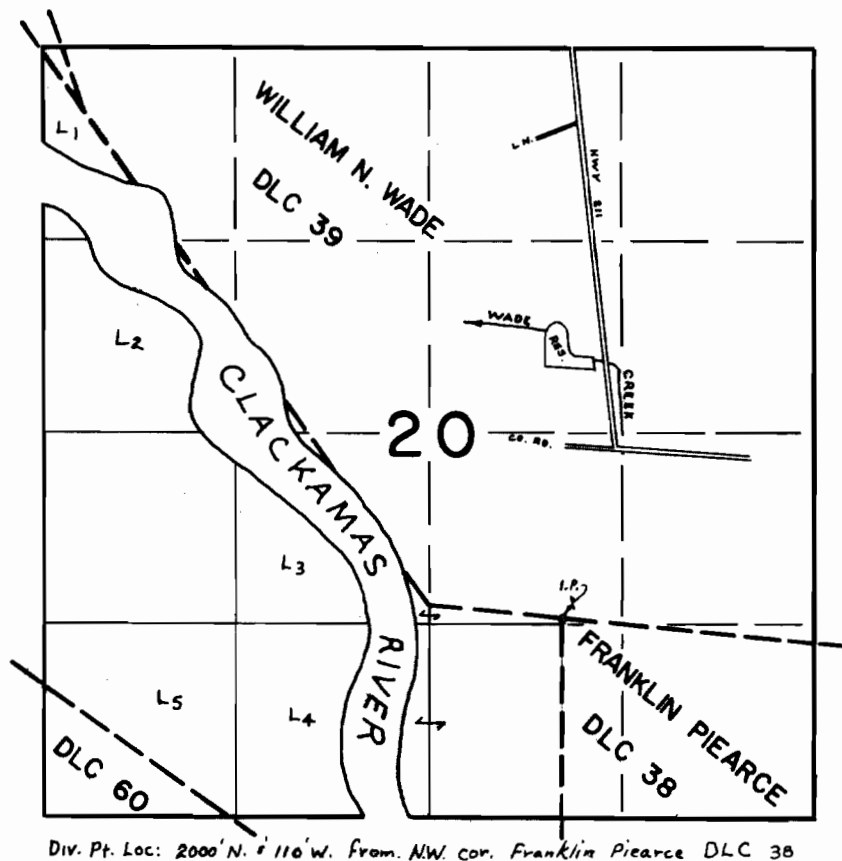

FINAL PROOF SURVEY
UNDER

Application No. R-42532 Permit No. R-4865

IN NAME OF

GLEN E. PARK

Surveyed Oct. 10, 1973, by R. MUCKEN