


T.4S.R.2E.W.M.

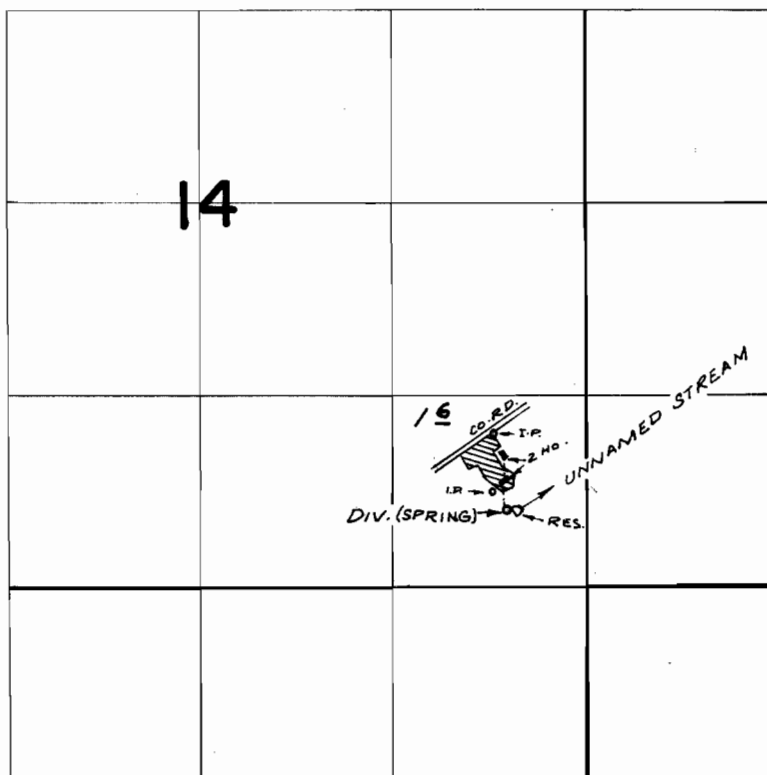

DIV. PTS. LOC: 530'N. & 780'E. ; 550'N. & 880'E. BOTH FROM
S.E. COR. SEC. 14

FINAL PROOF SURVEY
UNDER

Application No. R-44588 44589 Permit No. R-5279 33375
IN NAME OF

ARTHUR J. AGNINI

Surveyed JULY 27 1973, by R. MUCKEN