


T.5S.R.1E.W.M.

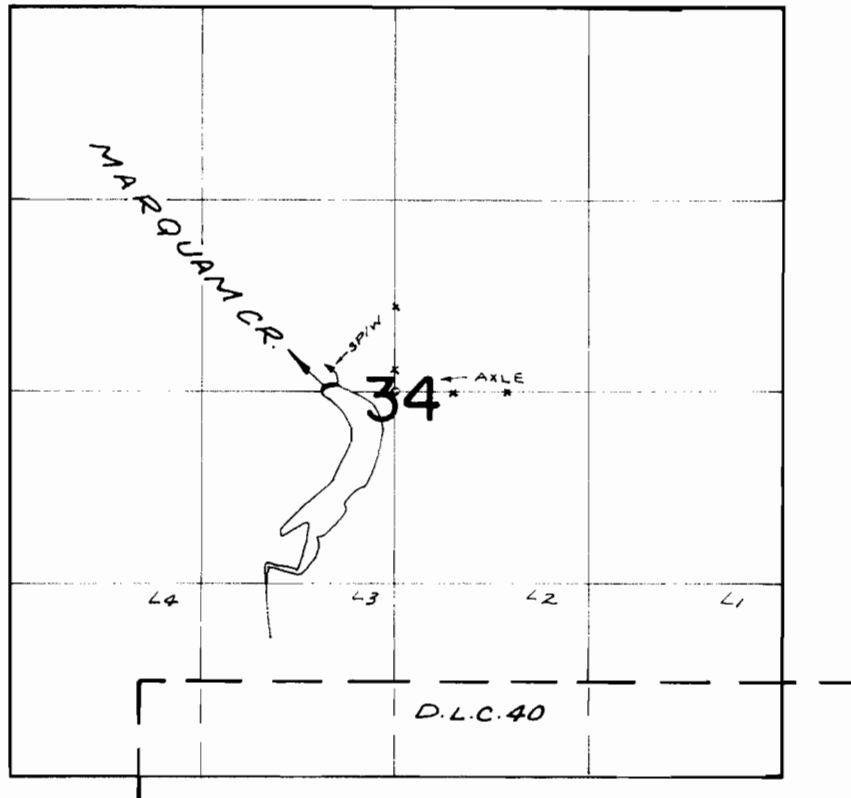

DIV. PT. LOC: 30' N. & 480' W FROM GEN. SEC. 34

FINAL PROOF SURVEY
UNDER

Application No. R-45093 Permit No. R-5326
IN NAME OF

JOSEPH F. DOBBES

Surveyed JULY 3, 1973, by R. MUCKEN