


T.3S.,R.2E.,W.M.

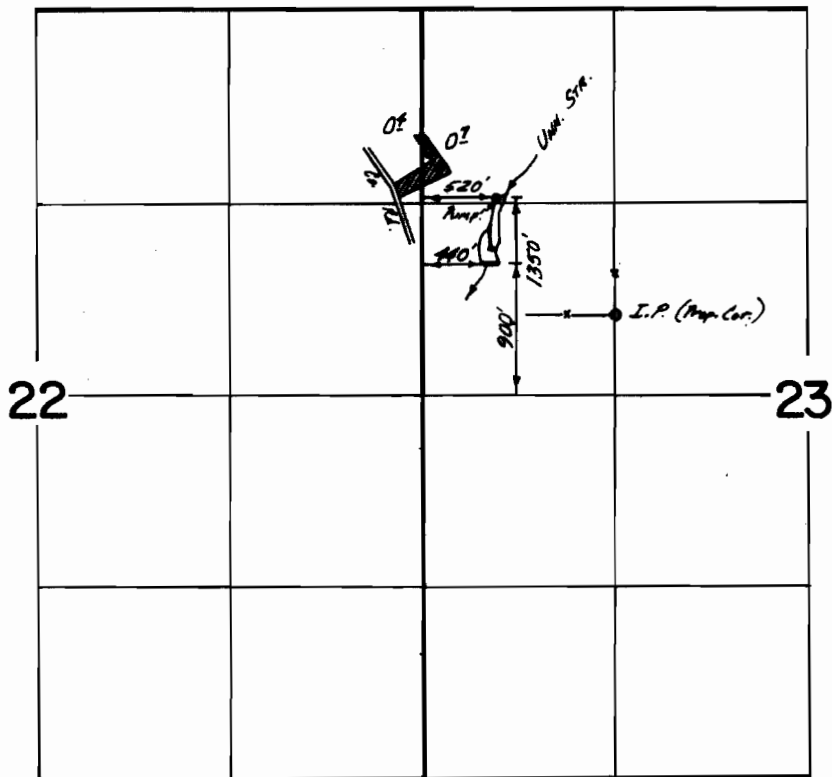

FINAL PROOF SURVEY
UNDER

R-46013 R-5472
Application No. 46014 Permit No. 34367
IN NAME OF

WALTER HEFT

Surveyed Aug. 2 1973, by D. NORBY