


T.6S., R.1E., W.M.

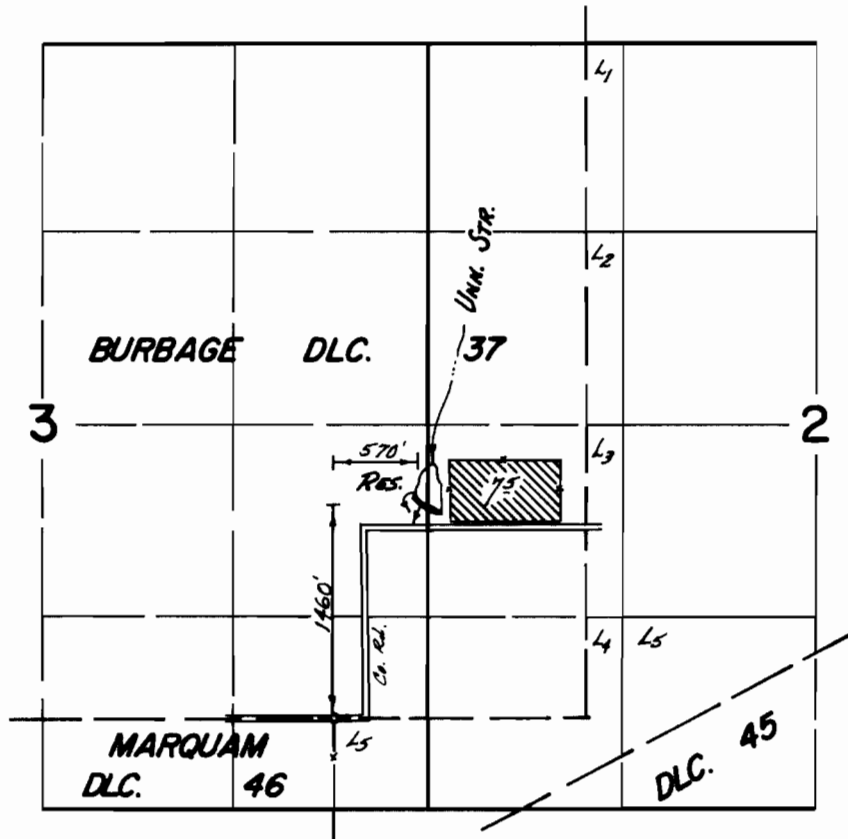

FINAL PROOF SURVEY
UNDER

R-46521 R-5547
Application No. 46522 Permit No. 34757
IN NAME OF

FRANK GEHRMAN

Surveyed July 25 1973, by D. NORBY