


T.6S., R.1E., W.M.

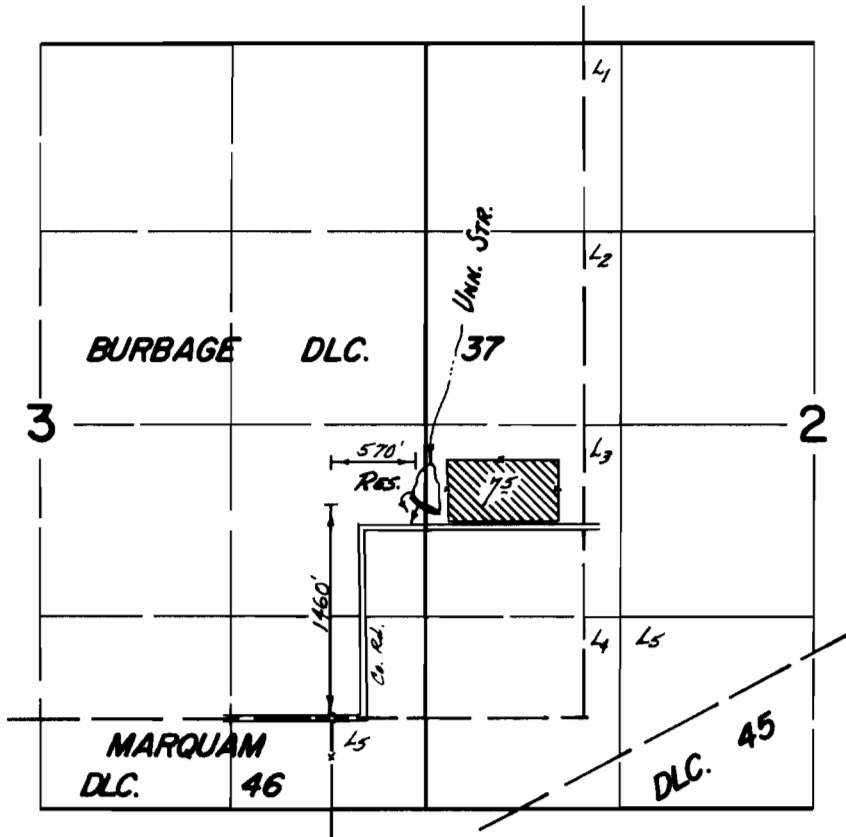

**FINAL PROOF SURVEY**  
UNDER

R-46521                      R-5547  
Application No. 46522    Permit No. 34757  
IN NAME OF

FRANK GEHRMAN

Surveyed July 25 1973, by D. NORBY