


T.4S.R.3E.W.M.

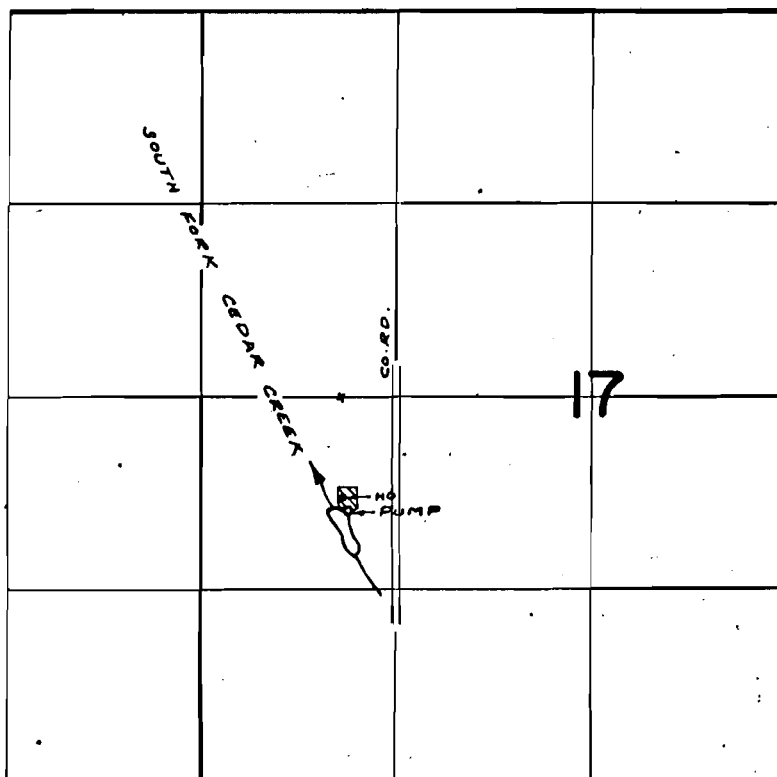

DIV. PTS. LOC: DAM - 170' S. & 430' W.; PUMP - 780' S. & 320' W., BOTH FROM N.E. COR. NW 1/4 SW 1/4 SEC. 17

**FINAL PROOF SURVEY**  
UNDER

Application No. R-47316 Permit No. R-5629  
46911 35095  
IN NAME OF

ROBERT A. FISHER

Surveyed JULY 26, 1973, by R. MUCKEN