


T.4S.R.3E.W.M.

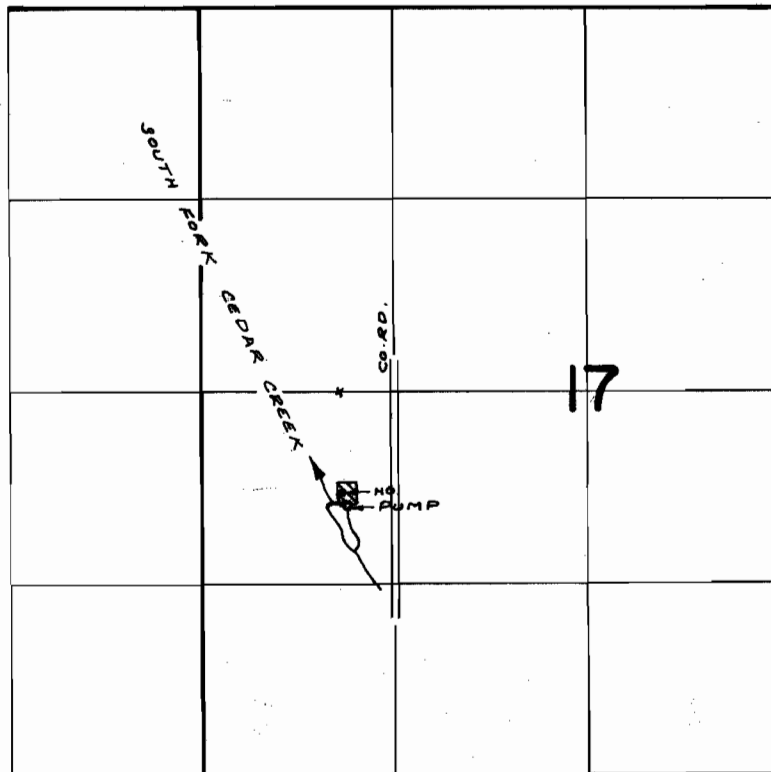

DIV. PTS. LOC: DAM - 770' S. & 430' W.; PUMP - 780' S. & 320' W., BOTH FROM N.E. COR. NW $\frac{1}{4}$ SW $\frac{1}{4}$ SEC. 17

FINAL PROOF SURVEY
UNDER

Application No. R-47316 Permit No. R-5629
46911 35095
IN NAME OF

ROBERT A. FISHER

Surveyed JULY 26, 1973, by R. MUCKEN