


T.2S. R.5E. W.M.

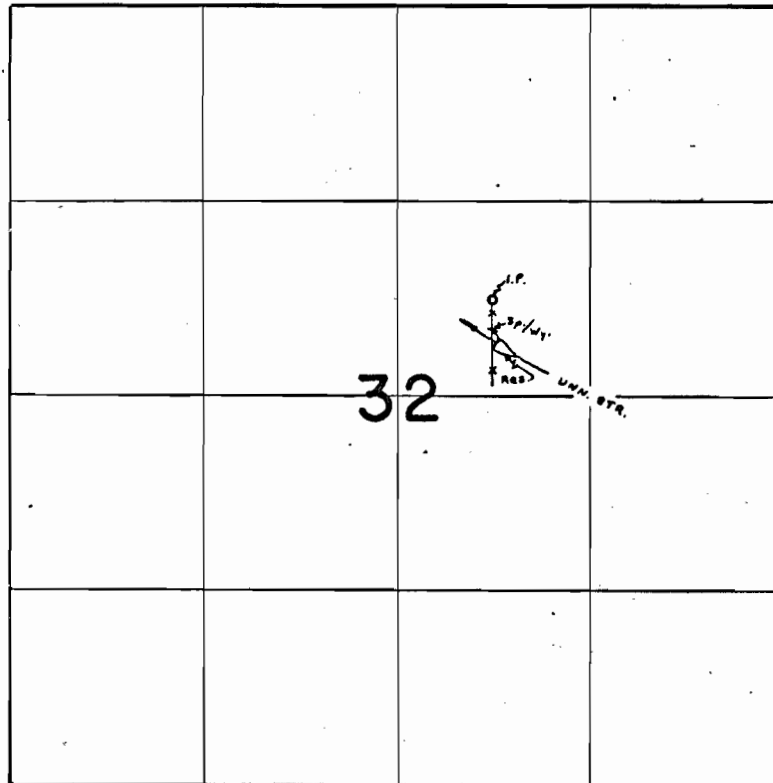

Div. Pt. Loc: 360' N. & 680' E. From cen. Sec. 32

FINAL PROOF SURVEY
UNDER

Application No. R-47643 47730 Permit No. R-5737 35682
IN NAME OF
KEITH M. COBURN

Surveyed Sept. 12, 1973, by R. MUCKEN