


T.3S.R.4E.W.M.

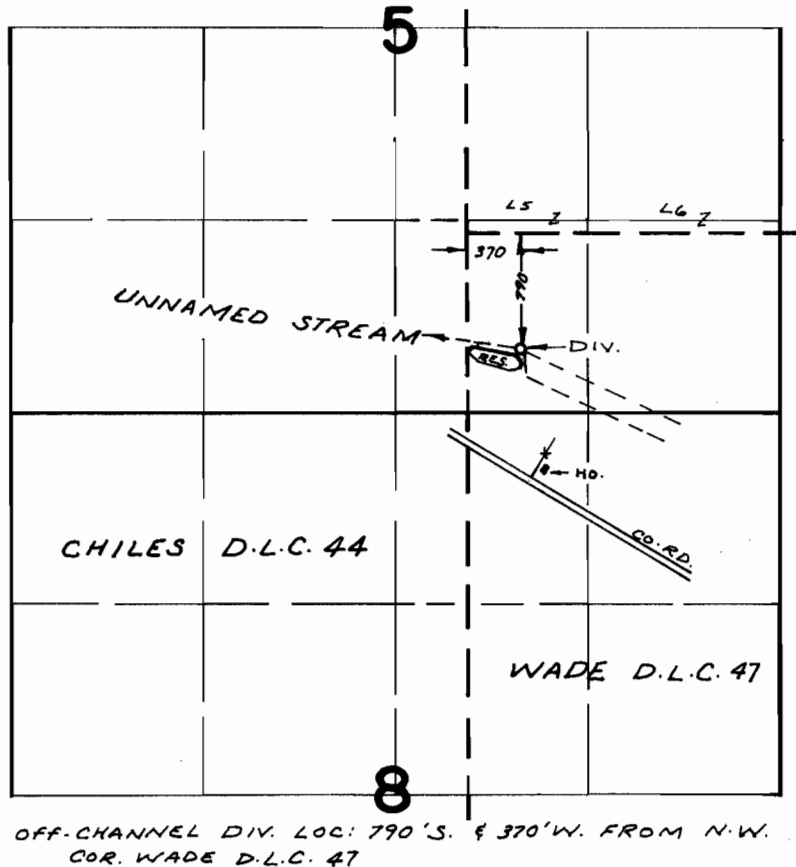

FINAL PROOF SURVEY
UNDER

Application No. R-47934 47935 Permit No. R-5798 35908
IN NAME OF

WALTER H. MAURER

Surveyed OCT. 2, 1973, by R. MUCKEN