


T.8 N. R.4 W. W.M.

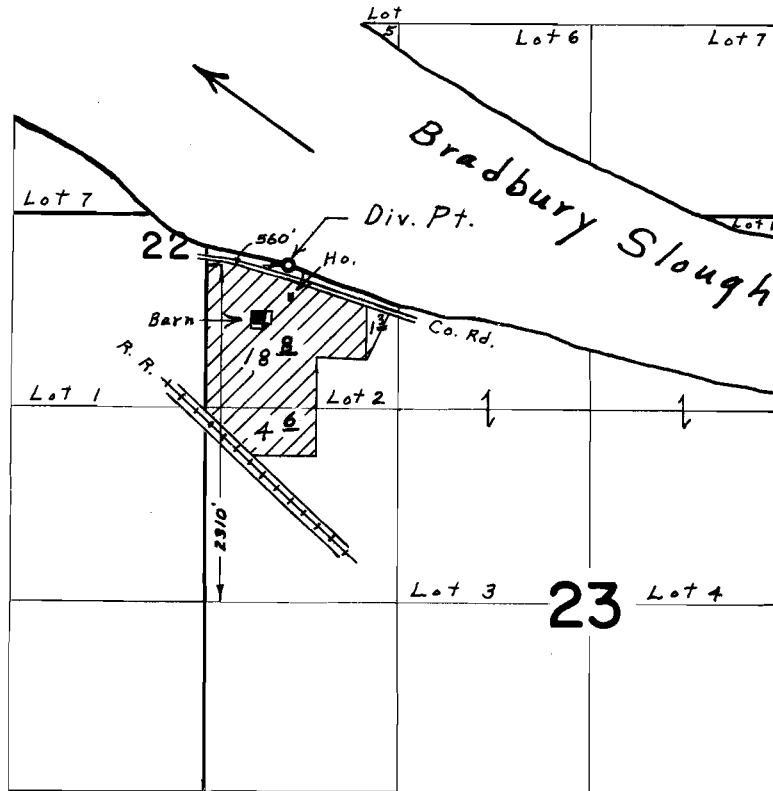

**FINAL PROOF SURVEY**  
UNDER

Application No. 48546 Permit No. 36434  
IN NAME OF

RONALD L. & VIOLET D. MARTIN

Surveyed July 10, 1973, by L. E. Gould