


T.27S., R.6W., W.M.

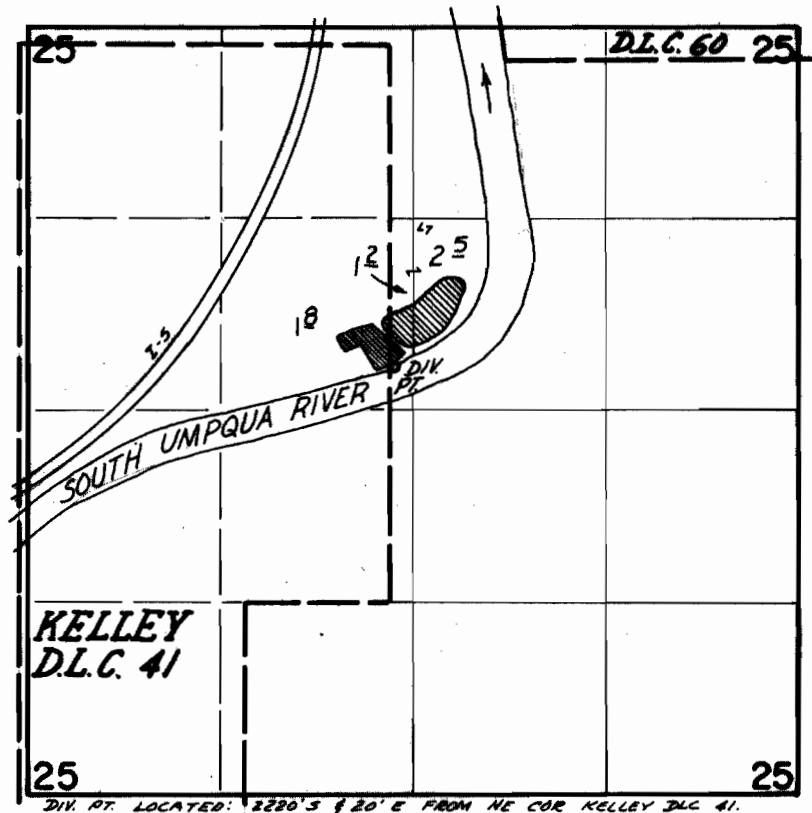

FINAL PROOF SURVEY
UNDER

Application No. 44981 Permit No. 33621
IN NAME OF

DOUGLAS COUNTY FAIR

Surveyed Sept 12 1973, by D. NOLBY