


T.27S., R.6W., W.M.

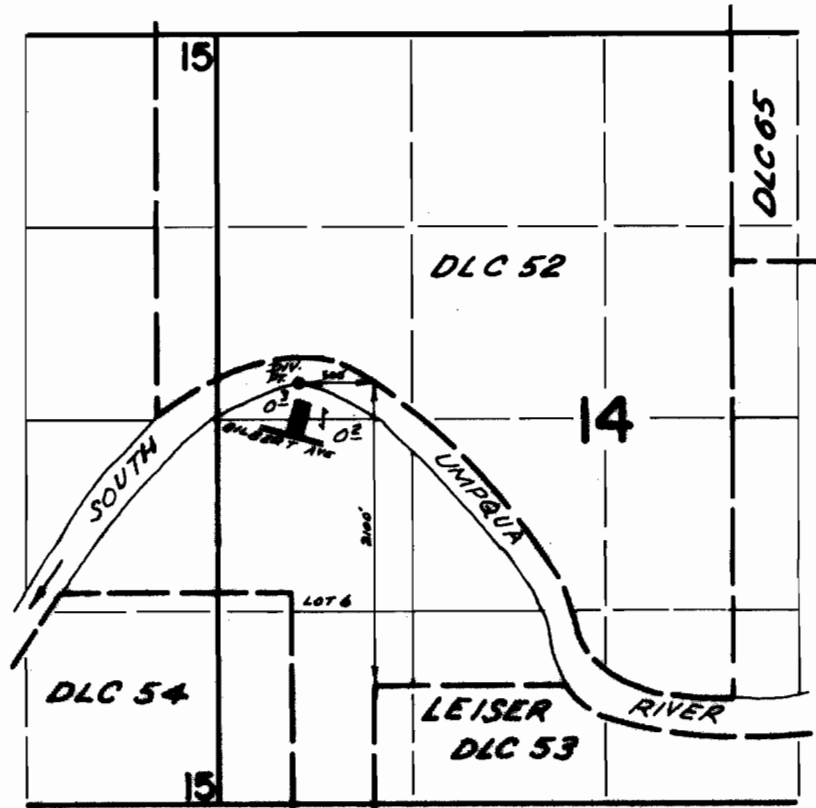

FINAL PROOF SURVEY
UNDER

Application No. 48591 Permit No. 36458
IN NAME OF

FRANCIS L. SULT, M.D.

Surveyed Sept 11 1993, by D. Noroy