


T.2N., R.10E., W.M.

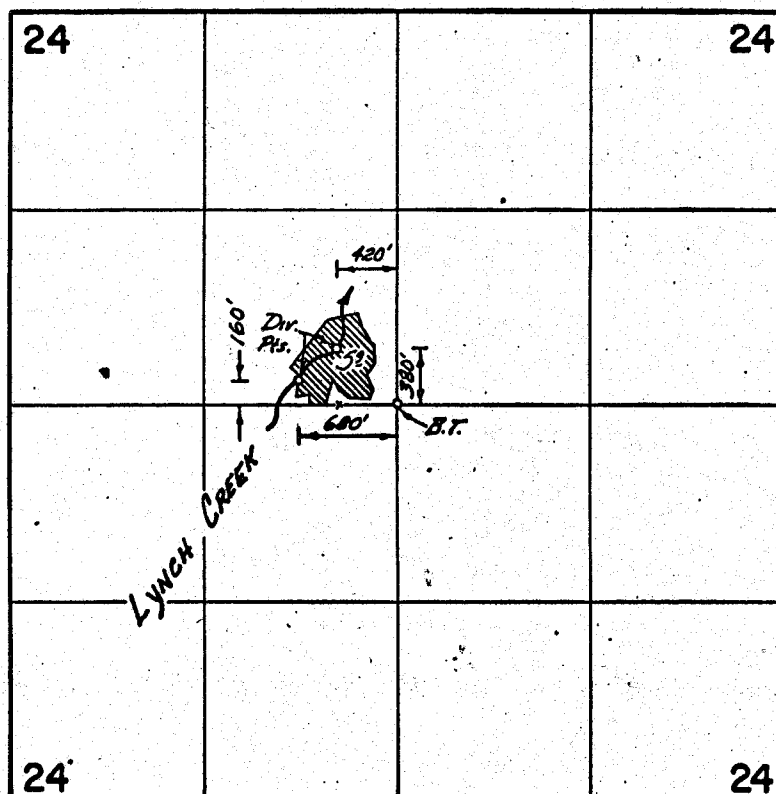

FINAL PROOF SURVEY
UNDER

Application No. 41362 Permit No. 30898

IN NAME OF

BOB NIEMINEN

Surveyed Aug. 29 1973, by D. NORBY