


T. 36 S. R. 4 W. W.M.

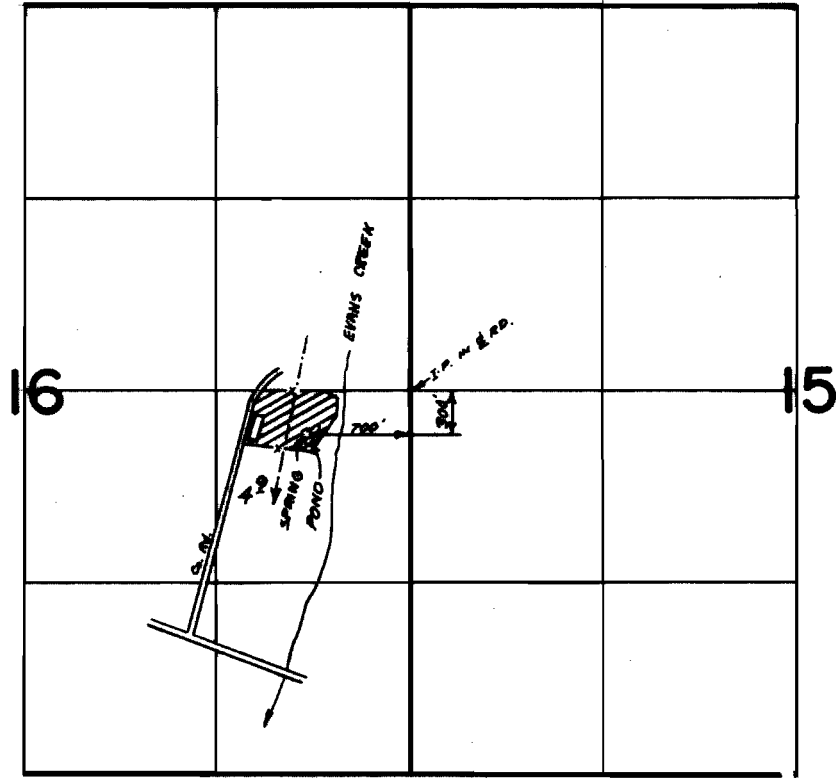

FINAL PROOF SURVEY
UNDER

Application No. 45392 Permit No. 33891
IN NAME OF

JACKSON COUNTY PARKS & RECREATION DEPARTMENT

Surveyed OCT 12 1973, by R.G. MUCKEN