


T.36 S. R.3 W. W.M.

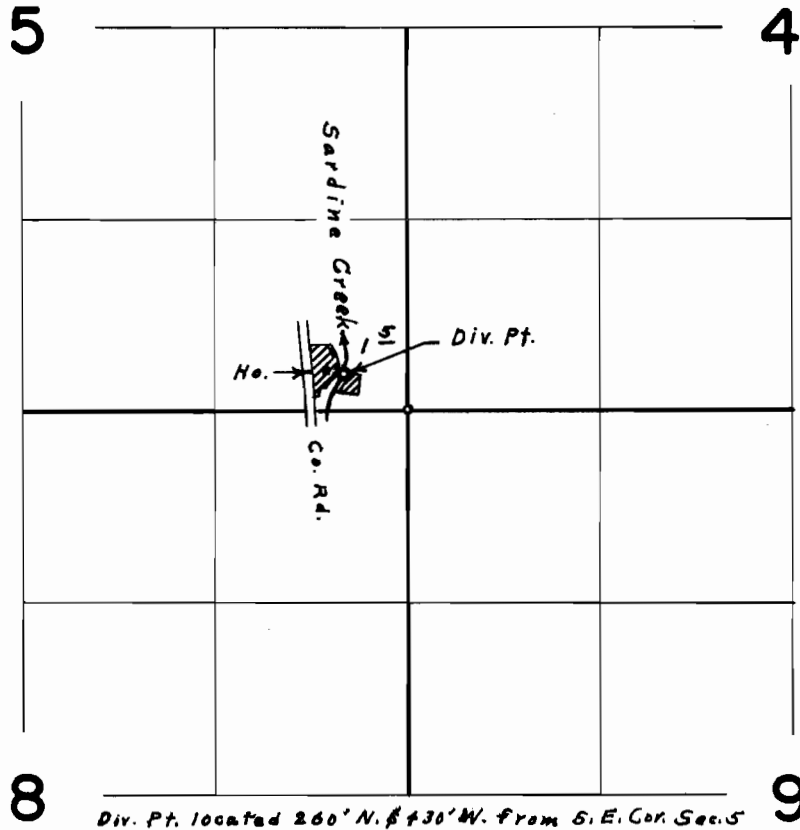

FINAL PROOF SURVEY
UNDER

Application No. 45895 Permit No. 34270
IN NAME OF

MARION E. MILLER

Surveyed Sept. 29 1973, by L. E. Gould