


T.4S., R.3W., W.M.

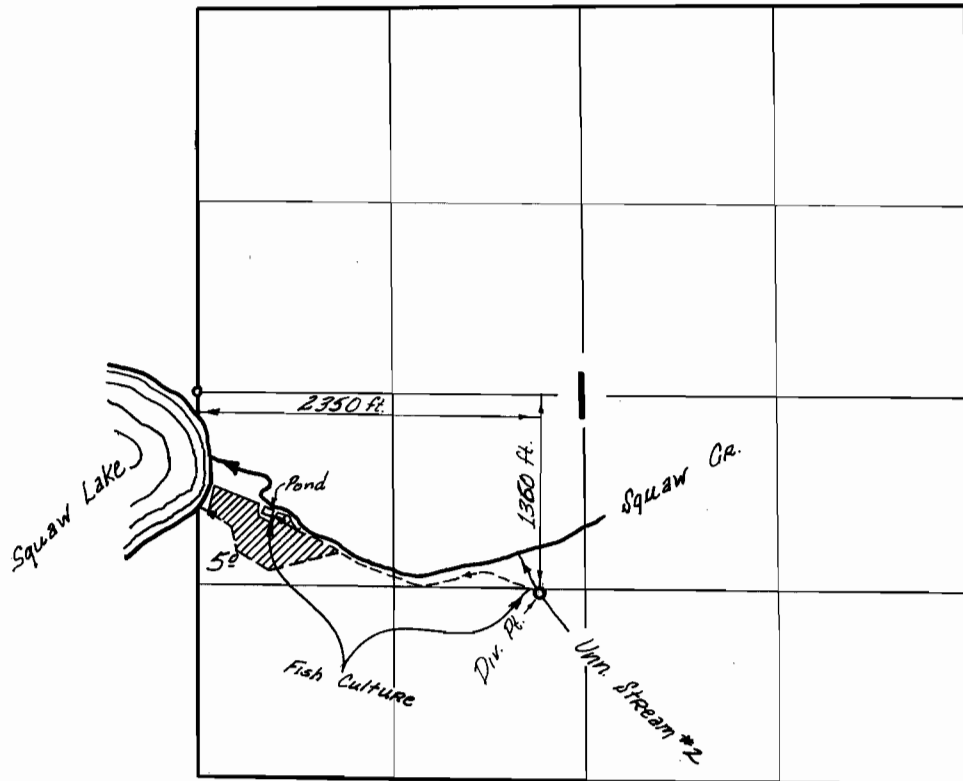

**FINAL PROOF SURVEY**  
UNDER

Application No. 47635 Permit No. 35649  
IN NAME OF

A. C. PIERCE

Surveyed Oct 13, 1973, by D. NORBY  
APRIL 14, 1961 R. JACKSON