


T.35S. R.3W. W.M.

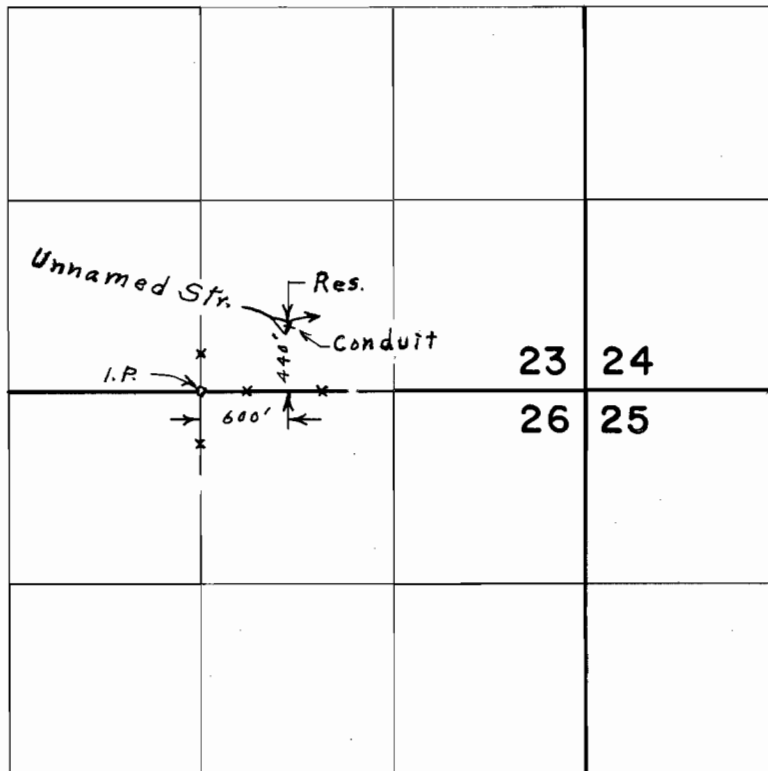

FINAL PROOF SURVEY
UNDER

R-41698 R-4704
Application No. 41699 Permit No. 31135
IN NAME OF

ESTATE OF JOHN L. GREGORY

Surveyed Oct. 1, 1973, by L. E. Gould